


G-4006  
38481 7

# T.4 N.R.28 E.W.M..

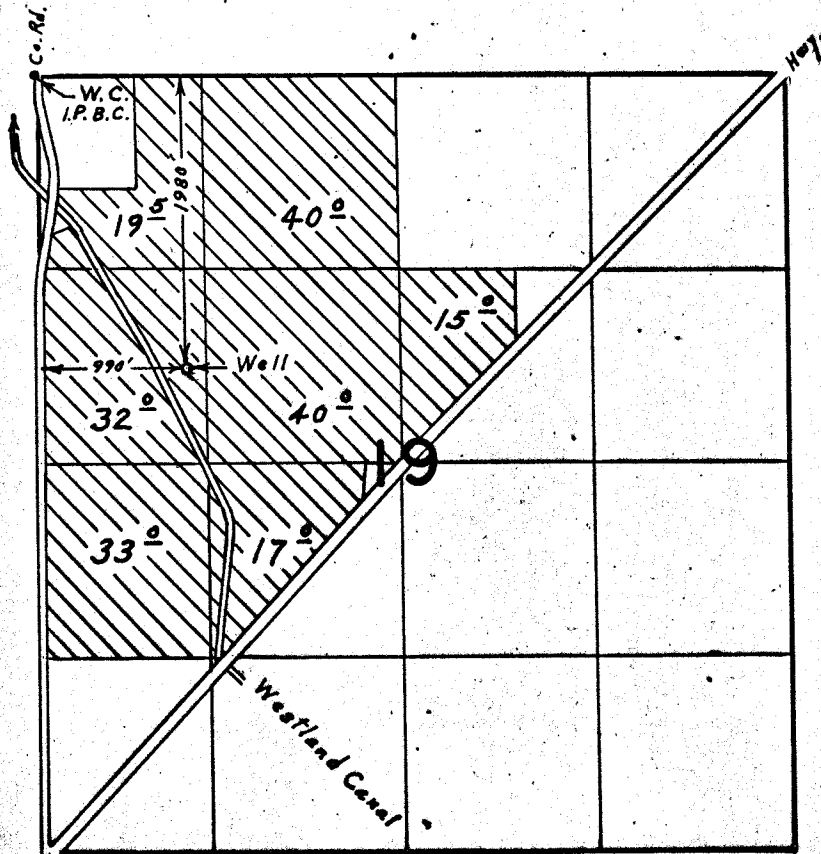

## FINAL PROOF SURVEY UNDER

Application No. G-4246 Permit No. G-4006  
IN NAME OF

**MALCOM SKINNER**

Surveyed June 25 1971, by L. E. Gould.