


T. 4 N. R. 27 E. W. M.

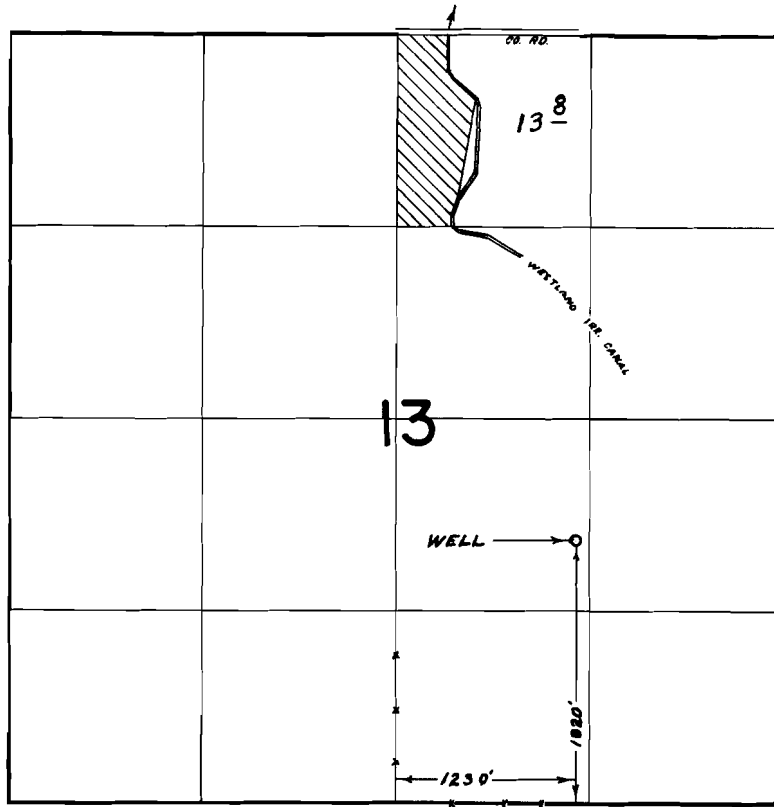

**FINAL PROOF SURVEY**  
UNDER

Application No. G-4291.. Permit No. G-4039..  
IN NAME OF

.....MALCOLM SKINNER.....

Surveyed AUG. 24, 1971., by L. E. GOULD...