


T. 2 N. R. 32 E. W. M.

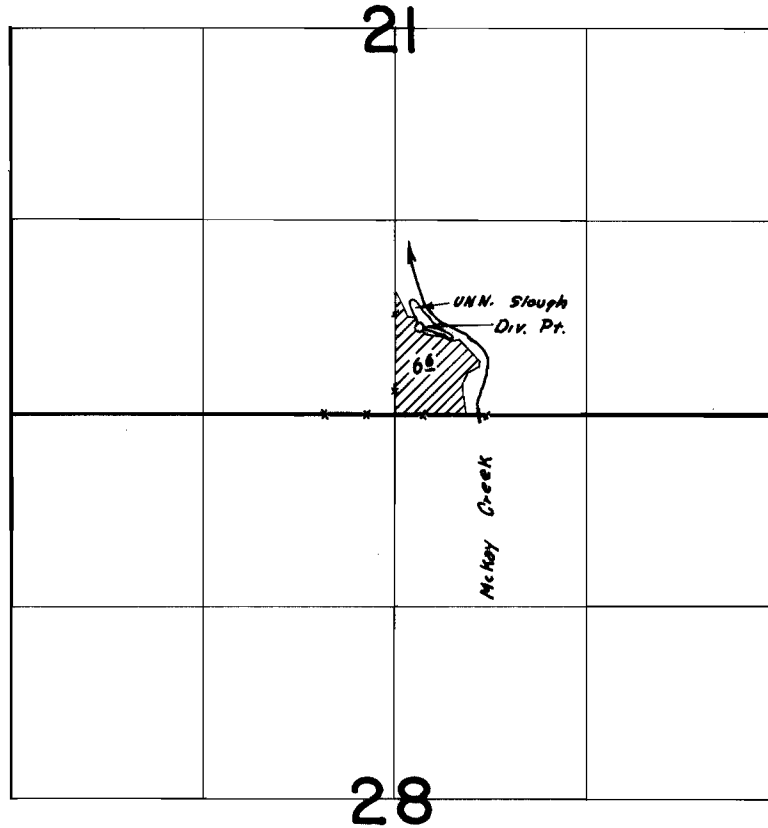

DIV. PT. LOC. 610' N & 160' E FROM S 1/4 COR. SEC. 21

FINAL PROOF SURVEY
UNDER

Application No. 37828... Permit No. 28206...
IN NAME OF

.....MRS. ANNA KOPP.....

Surveyed JUNE 25 1971, by G. Baga.....