


# T. 5 N. R. 28 E. W. M. .

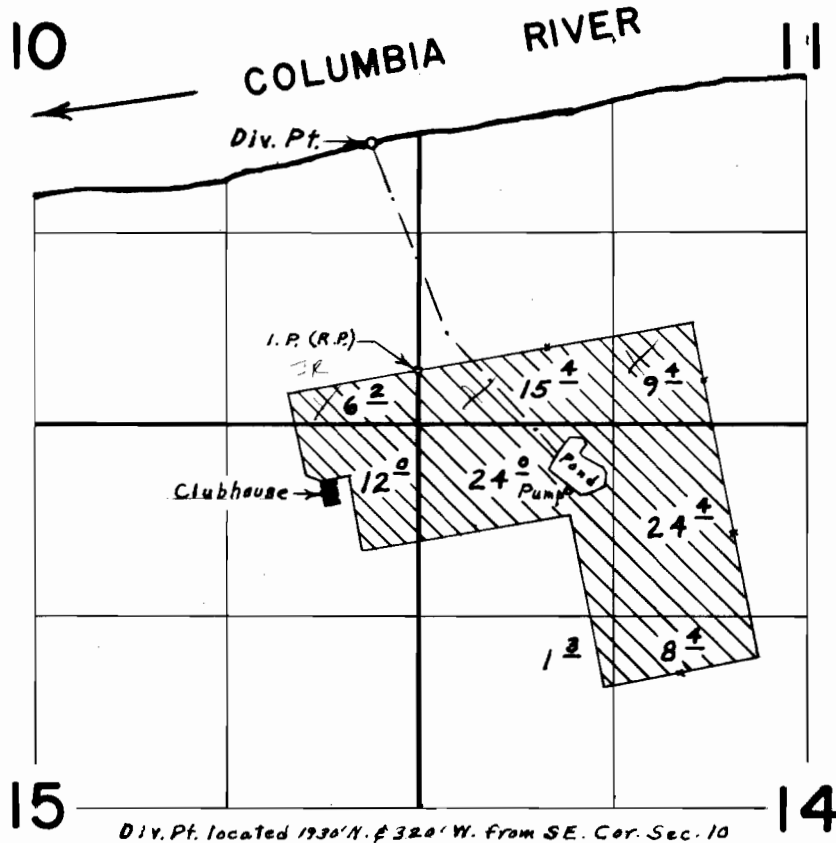

## FINAL PROOF SURVEY UNDER

Application No. 43529 Permit No. 32276  
IN NAME OF

McNARY GOLF CLUB, INC.

Surveyed July 8, 1969, by L. E. Gould  
Rechecked June 30, 1971