


T.1N.R.4W.W.M.

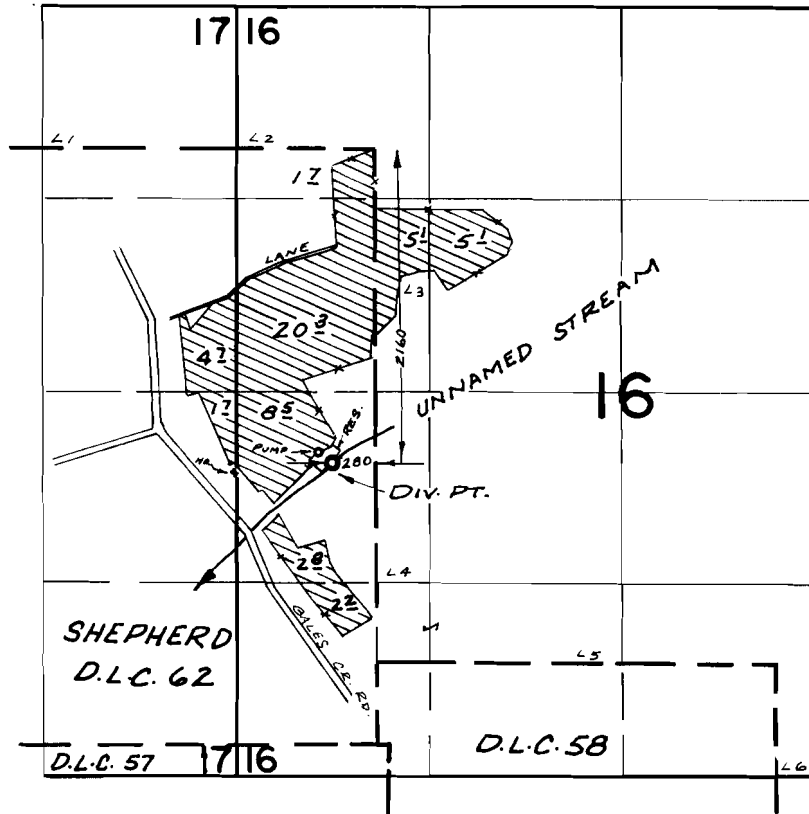

FINAL PROOF SURVEY UNDER

R-43095
Application No. 43096 Permit No. 32190 R-4907
IN NAME OF

PAUL J. CHOBAN

Surveyed *JUNE 14, 1971*, by *R. MUCKEN*.