


T.1N.R.4W.W.M.

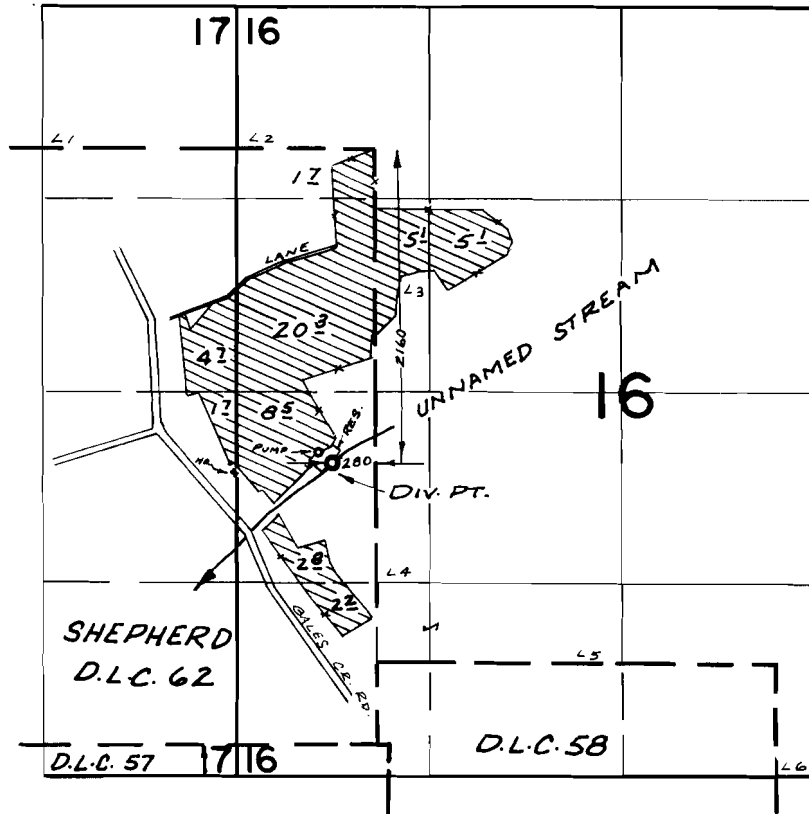

FINAL PROOF SURVEY UNDER

R-43095
Application No. 43096 Permit No. R-4907 32190
IN NAME OF

PAUL J. CHOBAN

Surveyed JUNE 14, 1971, by R. MUCKEN.