


T. 3 N. R. 5 W. W. M.

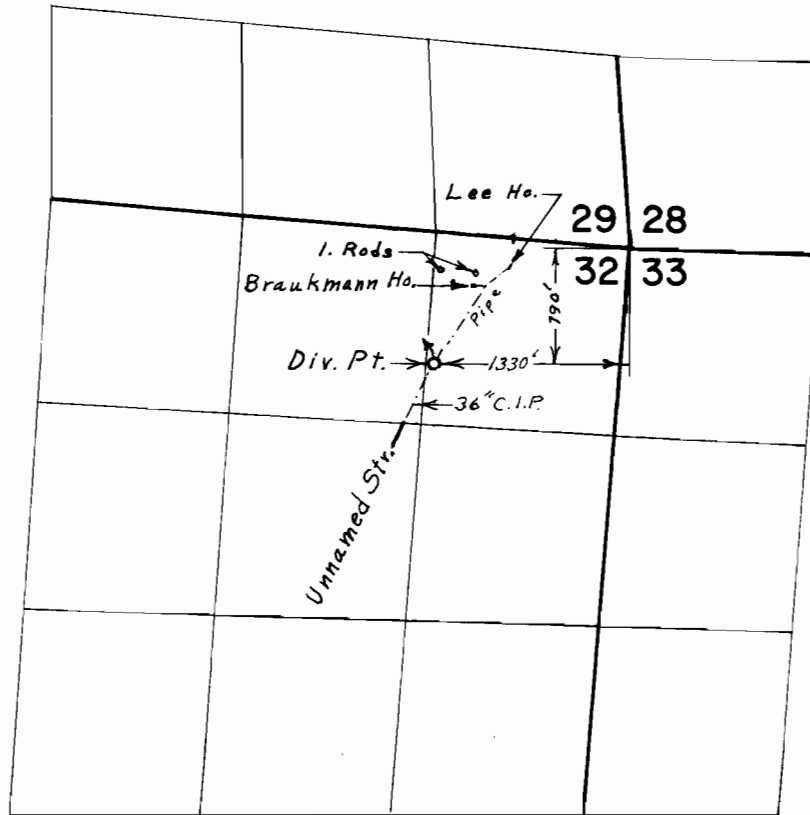

FINAL PROOF SURVEY
UNDER

Application No. 41577 Permit No. 31012
IN NAME OF

BEN W. & CLARA M. BRAUKMANN, JR. & ALAN LEE

Surveyed May 24, 1971, by L. E. Gould