


T. 1 N. R. 3 W. W. M.

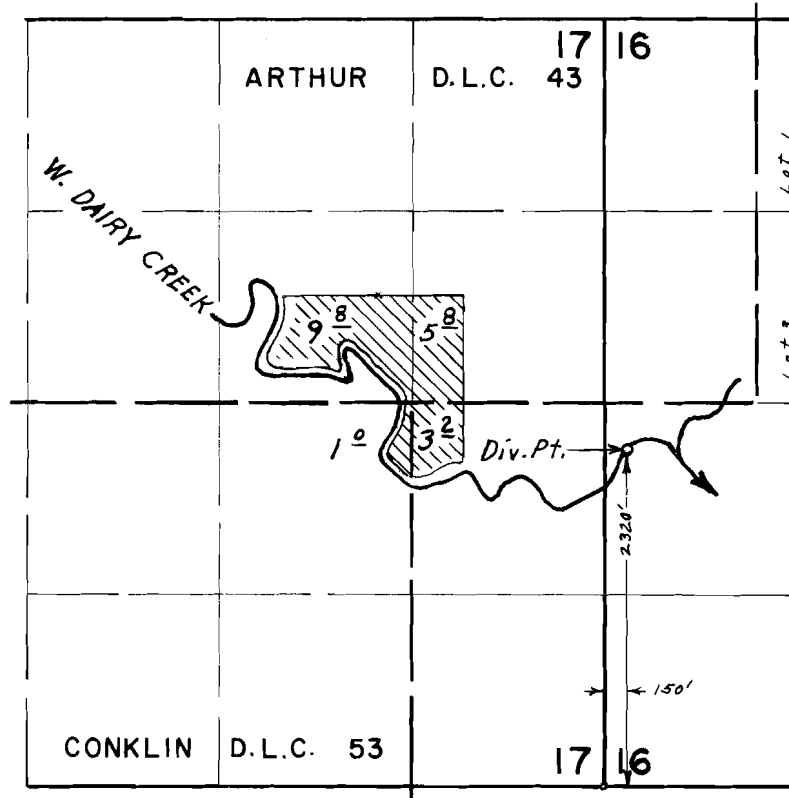

FINAL PROOF SURVEY UNDER

Application No. 45759 Permit No. 33999
IN NAME OF

LAWRENCE JANSEN

Surveyed May 28, 1971, by L. E. Gould