


T. 3 S. R. 3 W. W.M.

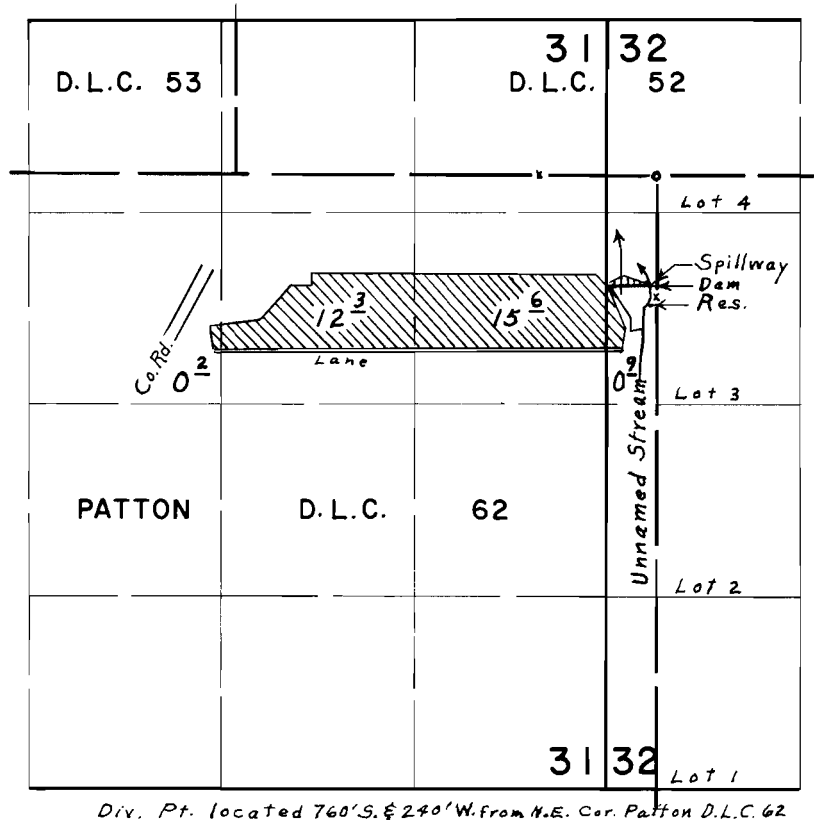

FINAL PROOF SURVEY UNDER

R-43991 R-5046
Application No. 43839 Permit No. 32768
IN NAME OF
FRELL C. ZINK

Surveyed Aug. 20, 1971, by L. E. Gould