


# T. 2 S. R. 5 W. W. M.

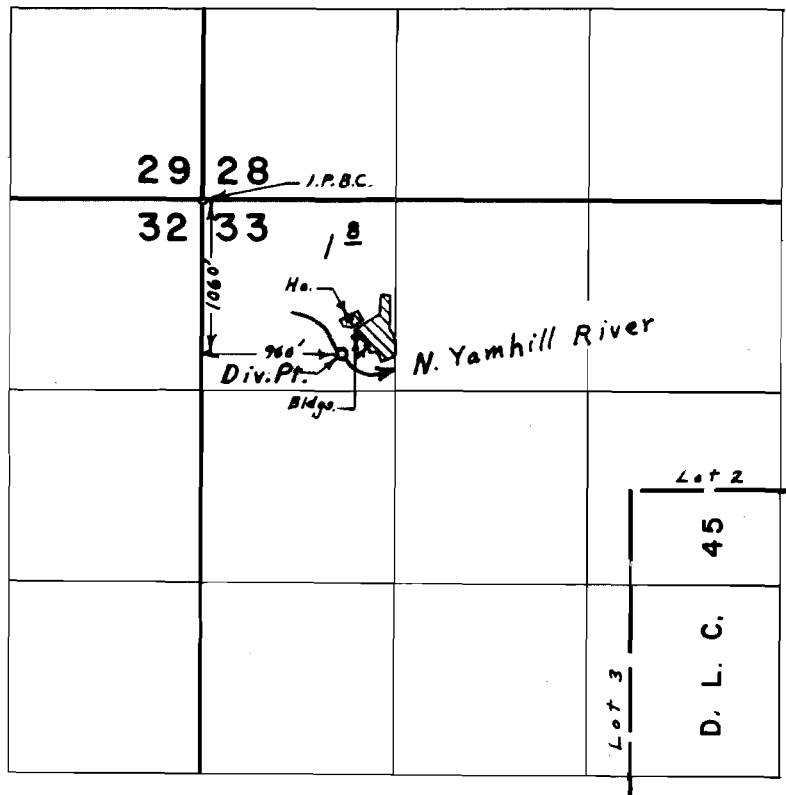

## FINAL PROOF SURVEY UNDER

Application No. 40995. Permit No. 30569.  
IN NAME OF

YAMHILL ENCAMPMENT CORP.

Surveyed July 9, 1971, by L. E. Gould.