


T. 3 S. R. 2 W. W. M.

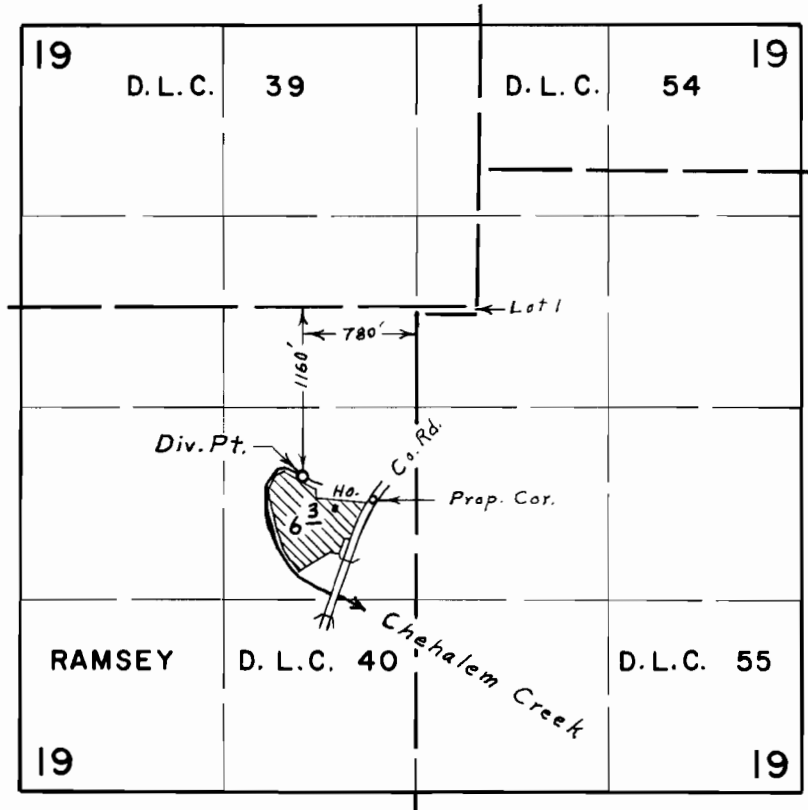

FINAL PROOF SURVEY UNDER

Application No. 41240 Permit No. 30756
IN NAME OF

EDWARD W. MORGAN

Surveyed July 30, 1971, by L. E. Gould