


# T. 3 S. R. 3 W. W. M.

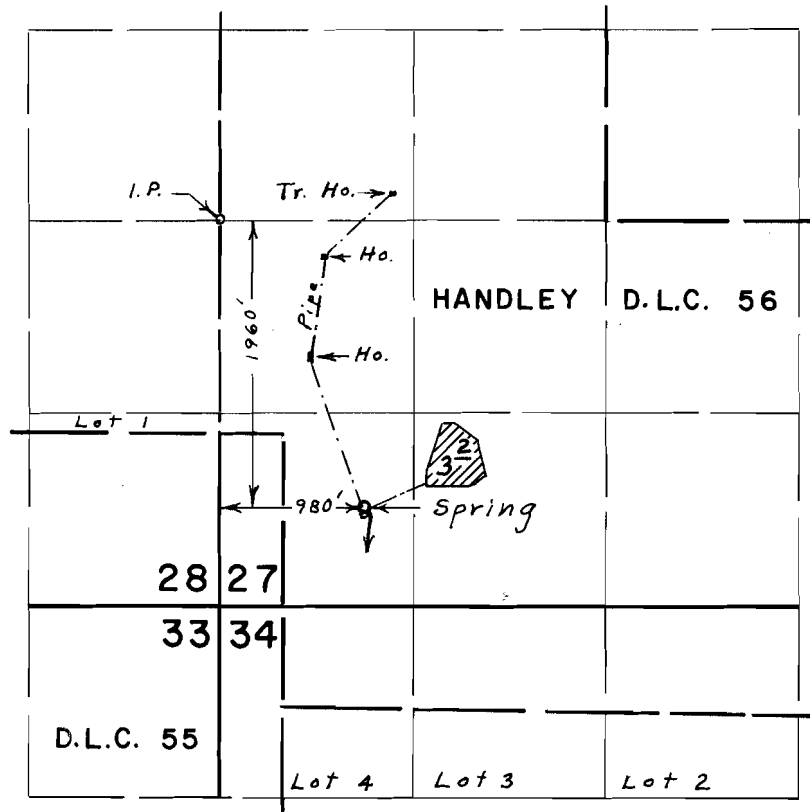

## FINAL PROOF SURVEY UNDER

Application No. 4 0958 Permit No. 30546  
4 4018 32902  
 IN NAME OF

JAMES A. MARESH

Surveyed Aug. 20, 1971, by L. E. Gould