


# T. 3 S. R. 3 W. W. M.

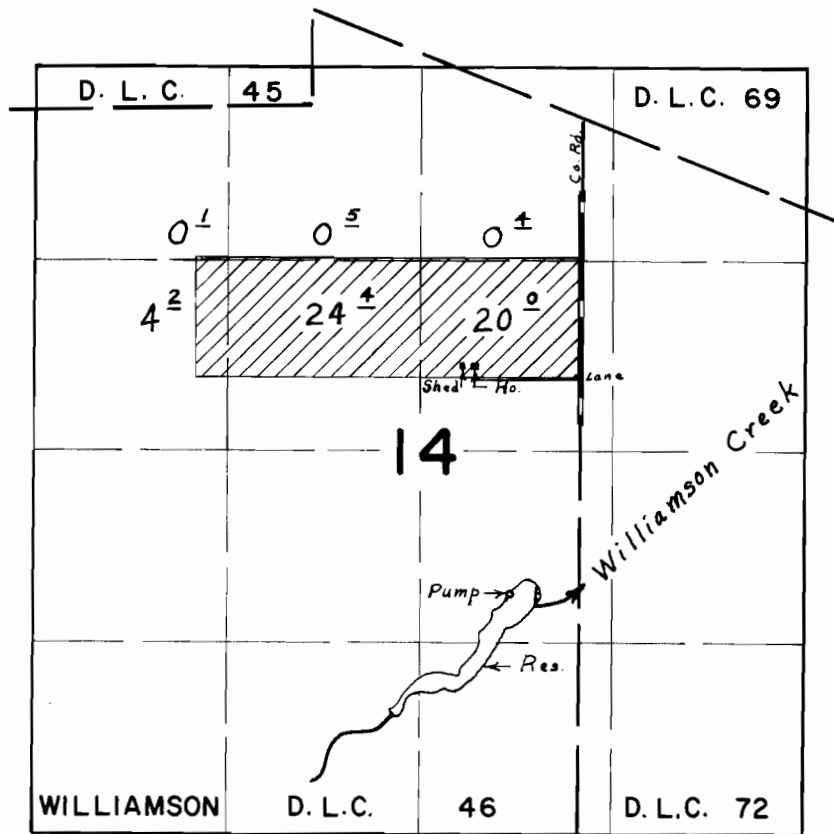

*Div. Pt. located 3330' S. & 300' W. from N.E. Cor. Williamson D.L.C. 46*

## FINAL PROOF SURVEY UNDER

Application No. 44834. Permit No. 33529.  
IN NAME OF

HERRING BROTHERS

Surveyed July 30, 1971., by L. E. Gould.