


T.5S. R.1E. W.M.

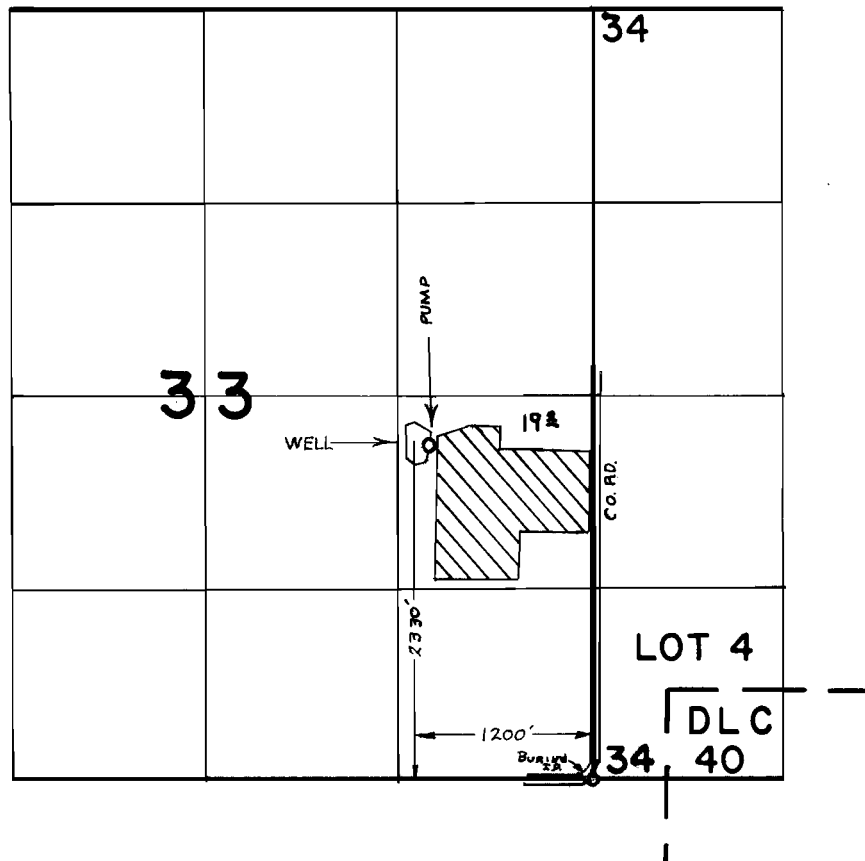

FINAL PROOF SURVEY
UNDER

Application No. G-1883 Permit No. G-1724
IN NAME OF

DONALD J. SCHAEFER

Surveyed Apr. 6, 1971, by R. MUCKER