


T. 3 S. R. 1 W. W. M.

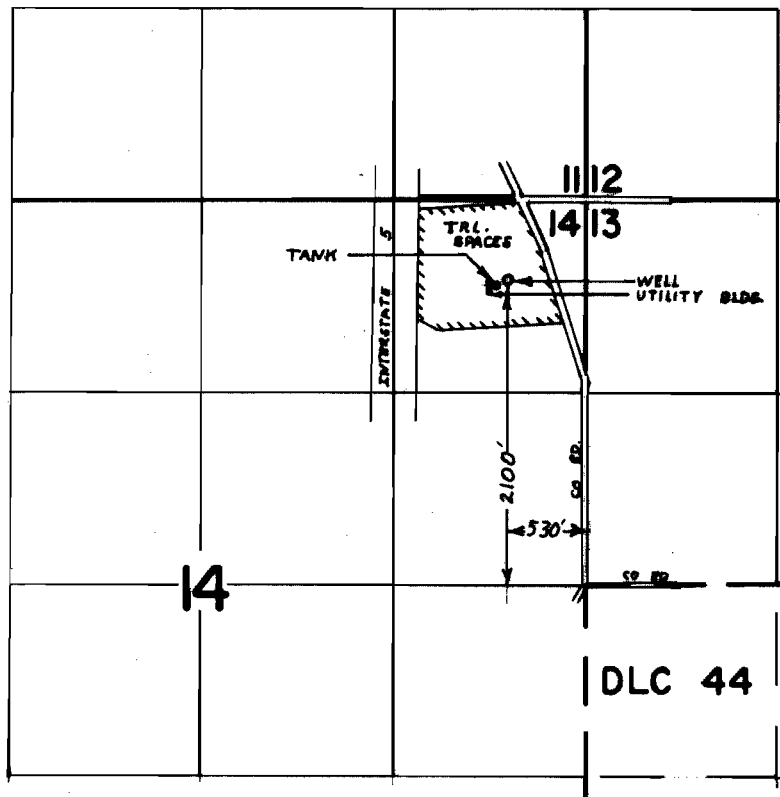

FINAL PROOF SURVEY UNDER

Application No. G. 2489... Permit No. G. 2331...
IN NAME OF

MILTON J. WERSHOW CO.

Surveyed JULY 9, 1971, by R. MUCKEN