


T.5S. R.1E.W.M.

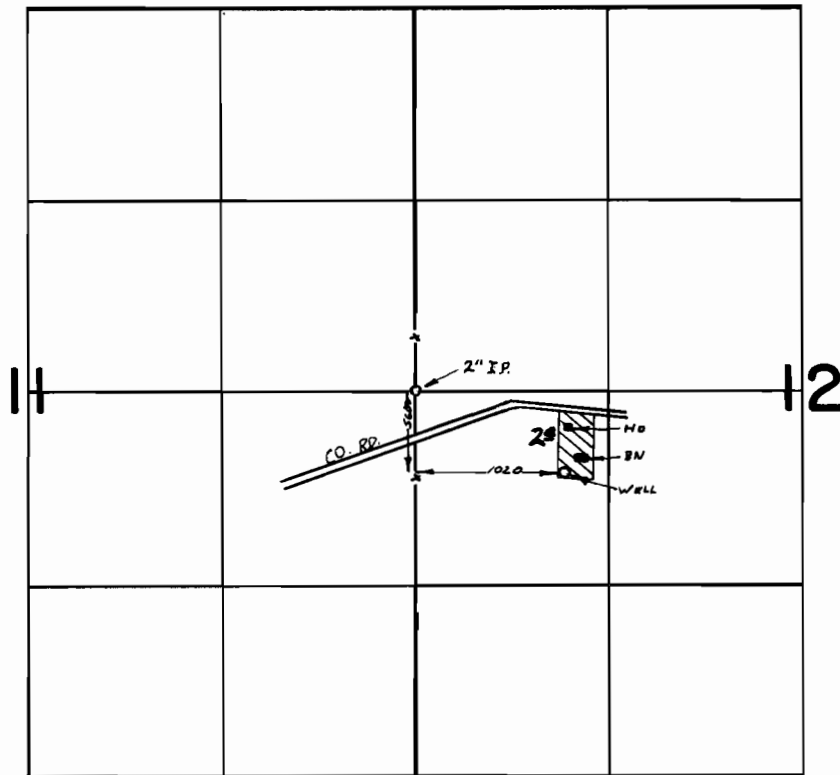

FINAL PROOF SURVEY
UNDER

Application No. G-3186 Permit No. G-2992
IN NAME OF

GILMAN SATRUM

Surveyed Apr 7, 1971, by B. MURPHY