


T. 3 S. R. 1 & 2 E. W. M.

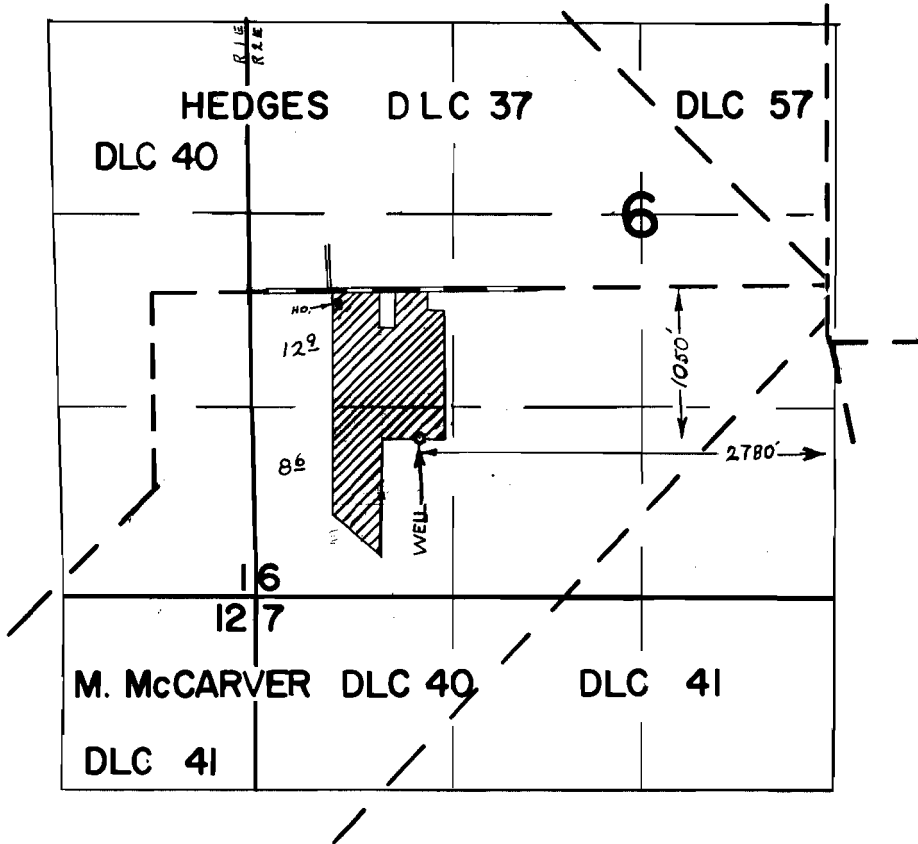

FINAL PROOF SURVEY UNDER

Application No. G-3424 Permit No. G-3210
IN NAME OF

CLIFFORD CHAPIN

Surveyed SEP. 27, 1971, by A. MACKEN