


T. 3 S. R. 1 W. W. M.

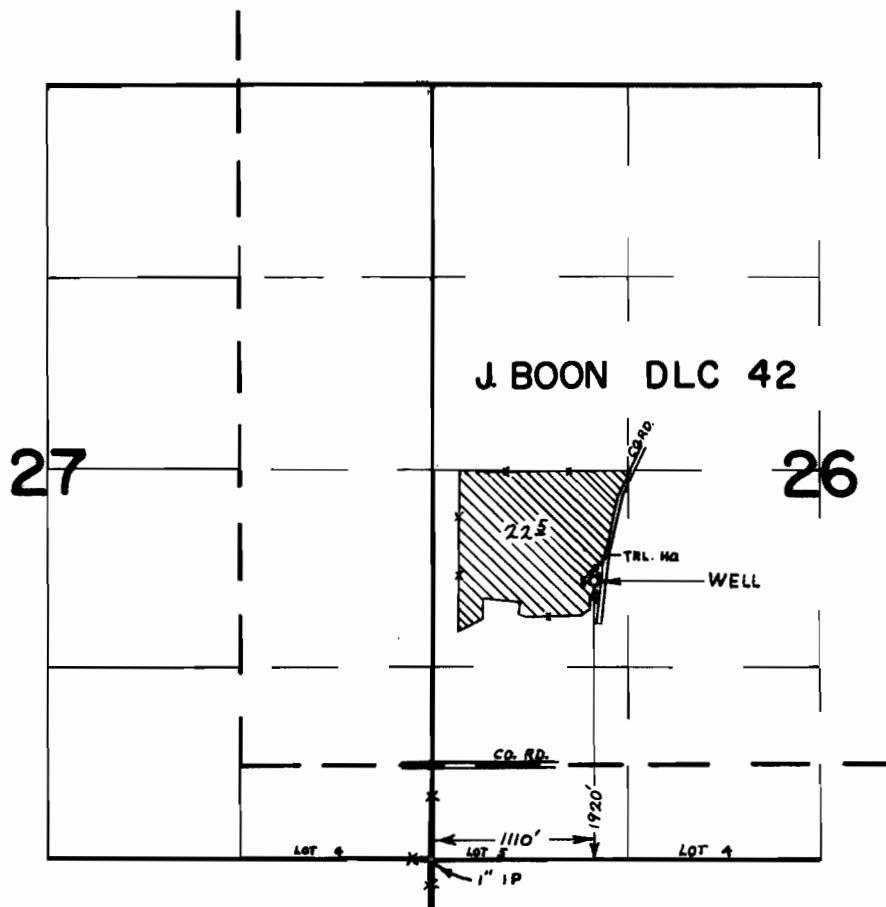

FINAL PROOF SURVEY
UNDER

Application No. ~~G-3682~~ Permit No. ~~G-3488~~
IN NAME OF

.....**WALTER J. NEUBERT**.....

Surveyed ~~SEP. 28,~~ 1971, by ~~R. MUCKEN~~.....