


T.5S.R.1E.W.M.

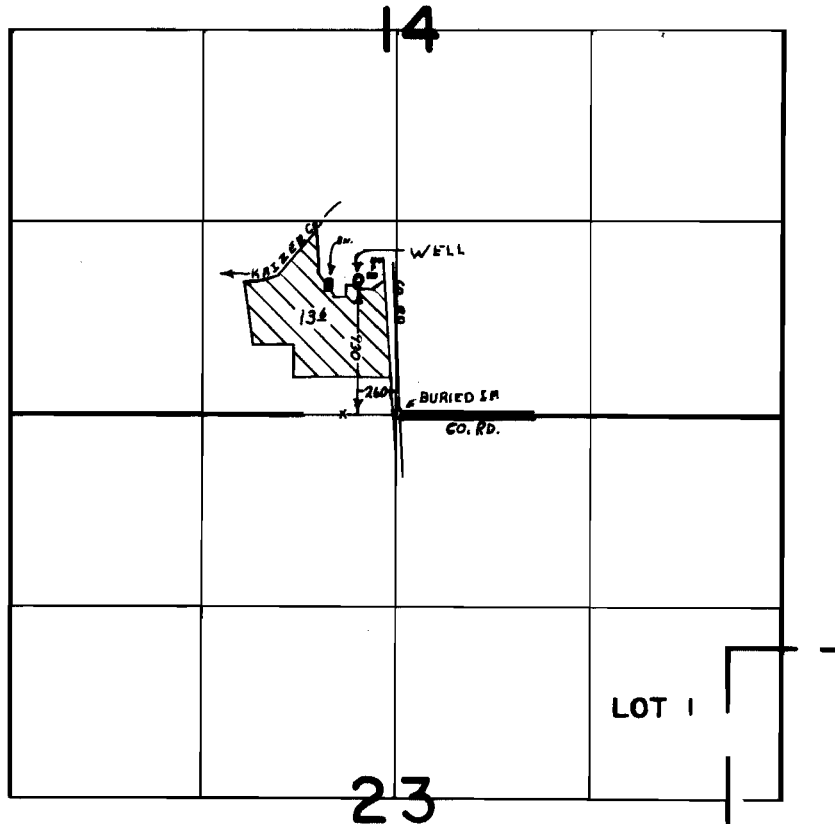

FINAL PROOF SURVEY
UNDER

Application No. G-3721.. Permit No. G-3517....
IN NAME OF

..... LEWIS O. VELLE

Surveyed APR..6... 1971.., by R. MUCKEN.....