


# T.4S.R.IE.W.M.

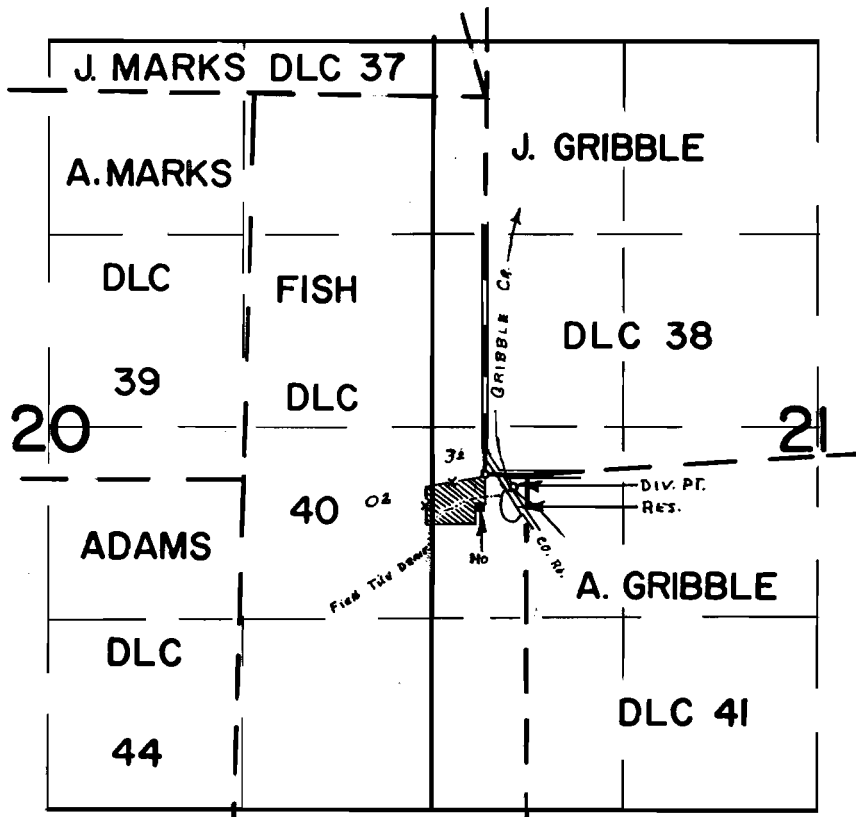

DIV. PTS. LOC.: CR.-70' S. & 190' E.; RES. DRAIN-130' S. & 170' E.; BOTH FROM SW COR. J. GRIBBLE DLC 38

## FINAL PROOF SURVEY UNDER

G-3870  
R-43435

G-3643  
R-4987

Application No. 43436 Permit No. 32474  
IN NAME OF

*JOHN H. PETERS*

Surveyed APR. 28, 1971, by R. MUCKEN