


T.1S.R.3E.W.M.

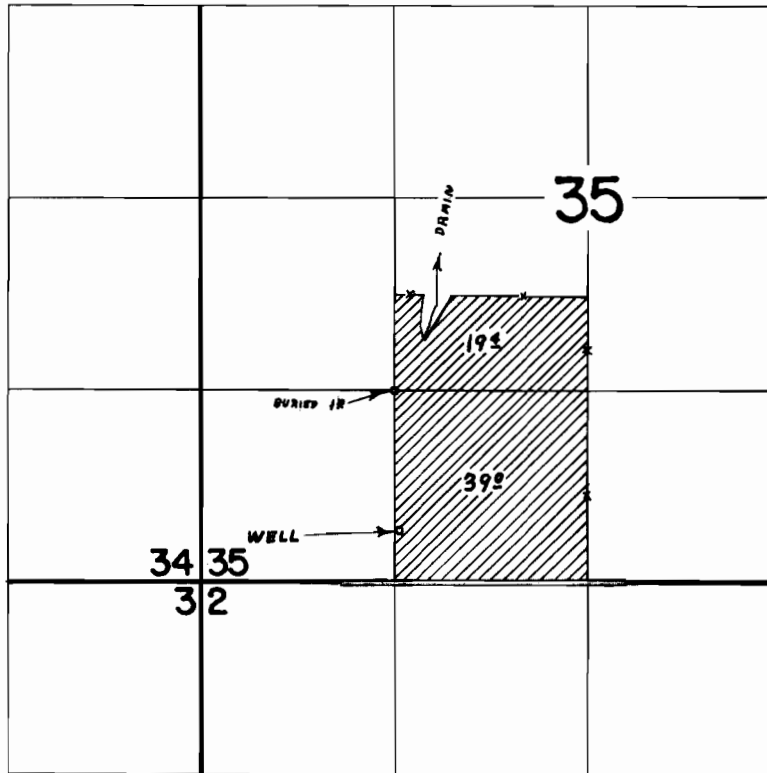

WELL LOC. 960'S 30'E FROM NW COR. SE 1/4 SW 1/4 SEC 35

FINAL PROOF SURVEY UNDER

Application No. G. 3984 Permit No. G. 3740
IN NAME OF

VICTOR & BETTY JEAN THOMPSON

Surveyed JULY 30, 1971, by R. MUCKEN