


T.2S.R.3E.W.M.

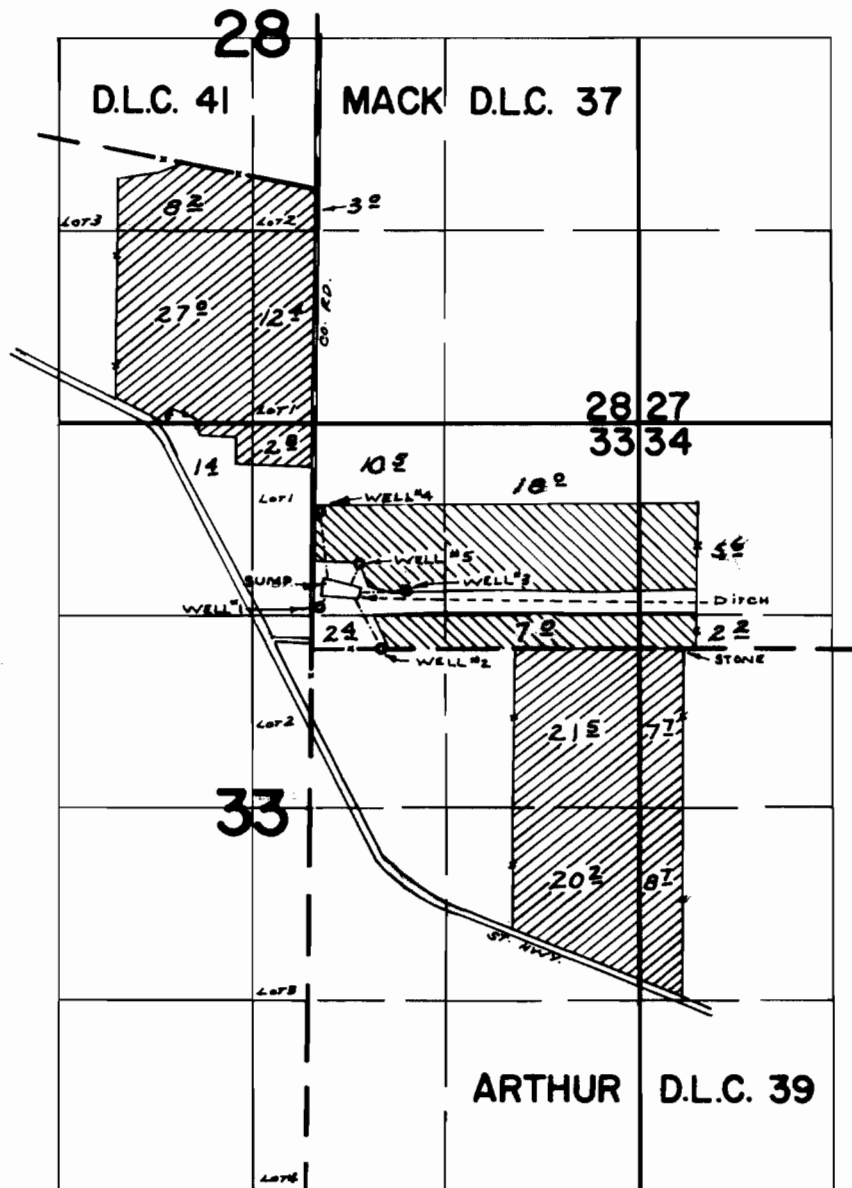

WELLS LOC: BUMP- 400'N. & 200'E.; #1- 290'N. & 50'E.; #2- 470'E.;
#3- 400'N. & 630'E.; #4- 940'N. & 50'E.; #5- 580'N. & 320'E.,
ALL FROM S.W. COR. MACK D.L.C. 37

 - APPL. G-4551

 - APPL. G-4901

FINAL PROOF SURVEY UNDER

Application No. G-4551 Permit No. G-4278
IN NAME OF G-4901 G-4619

ELMORE MOSTUL

Surveyed Nov. 17, 1971, by R. MUCKEN