


# T.2S.R.1E.W.M.

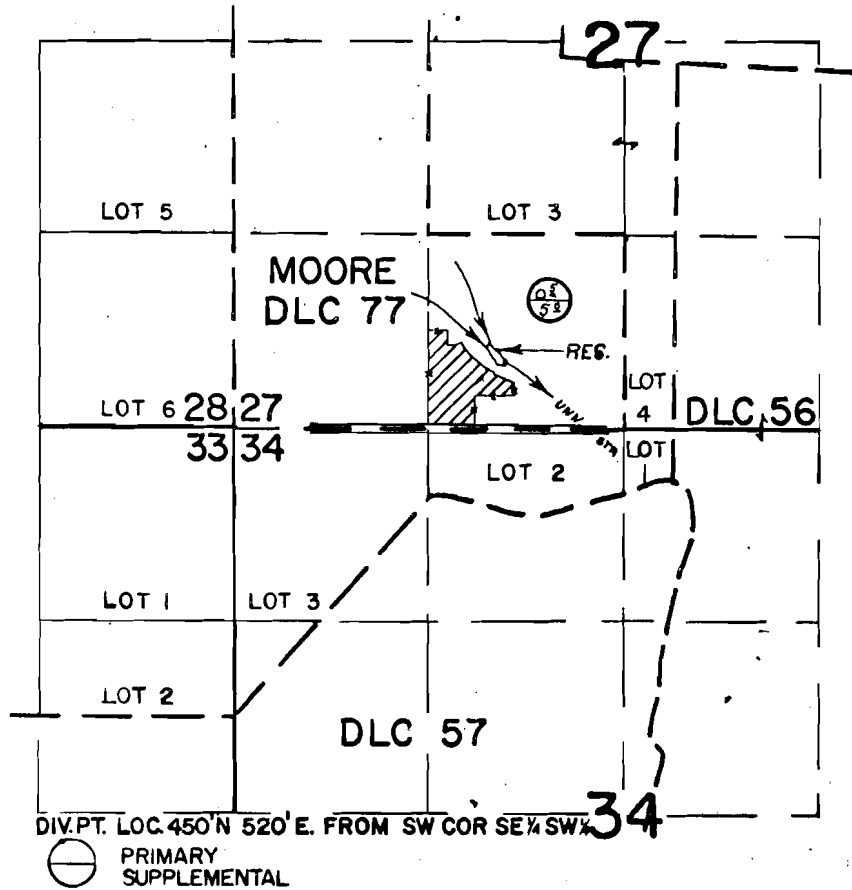

## FINAL PROOF SURVEY UNDER

39456 29298  
Application No. R-39268. Permit No. R-3891....  
IN NAME OF

.....CLARKE HUGHES.....

Surveyed JULY 8, 1971, by R. MUCKEN.....