


T.2S.R.4E.W.M.

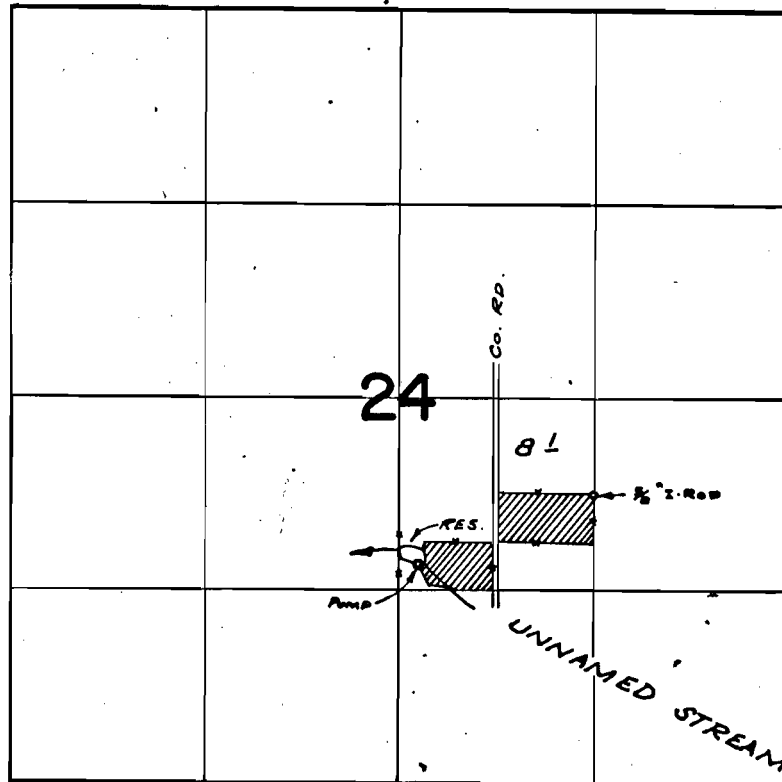

DIV. PT. LOC: 390' S. & 1320' W. FROM N.E. COR. S $\frac{1}{2}$ NW $\frac{1}{4}$ SE $\frac{1}{4}$ SEC. 24

FINAL PROOF SURVEY
UNDER

R-40635 R-4554
Application No. 40636 Permit No. 30276...
IN NAME OF

LESLIE W. WALLACE

Surveyed Nov. 19, 1971, by R. MUCKEN