


T.4S.R.3E.W.M.

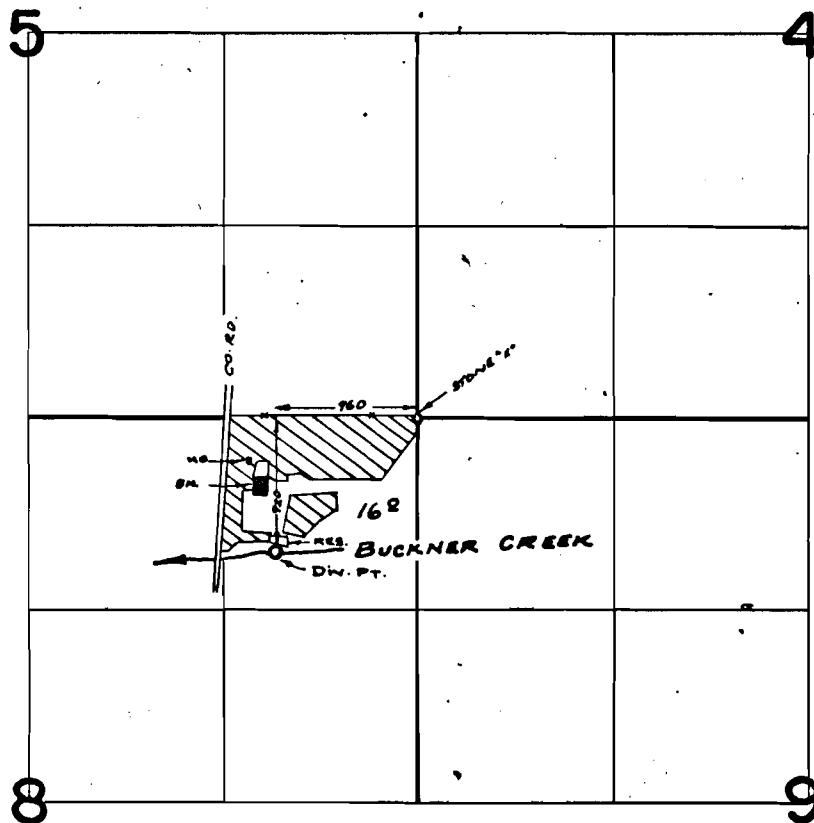

FINAL PROOF SURVEY
UNDER

Application No. R-43170 43171 Permit No. R-4937 32271
IN NAME OF

H. H. & HOWARD BICKET

Surveyed MAY 18 1971, by R. MUCKEN