


T.2S.R.3E.W.M.

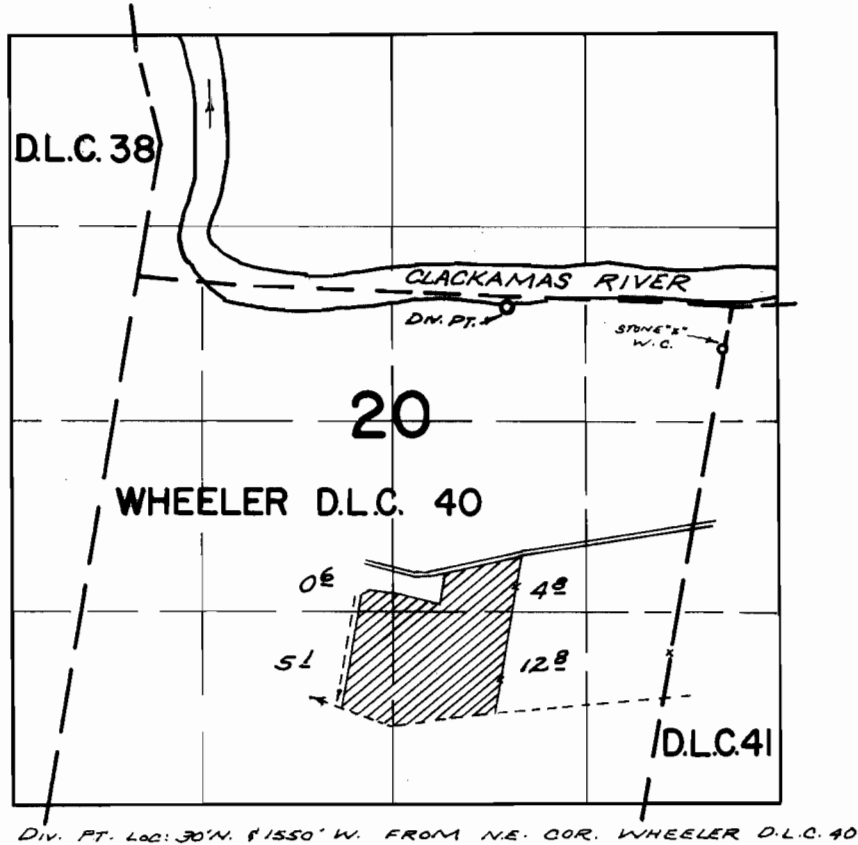

**FINAL PROOF SURVEY**  
UNDER

Application No. 37845 Permit No. 22497  
IN NAME OF

O. THOMAS HOGG

Surveyed Nov. 17, 1971, by R. MUGGEN.