


T.6S.R.2E.W.M

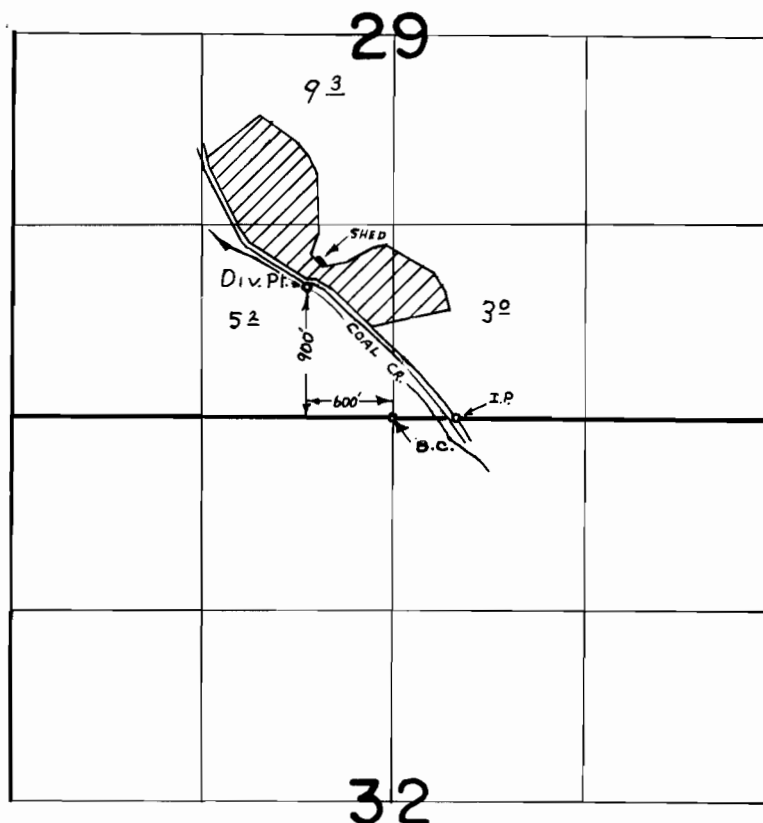

FINAL PROOF SURVEY
UNDER

Application No. **39671** Permit No. **29468**
IN NAME OF

GLEN M. SLENTZ

Surveyed **APR. 5** 19**71**, by **R. MUCKEN**