


T.4S.R.3E.W.M.

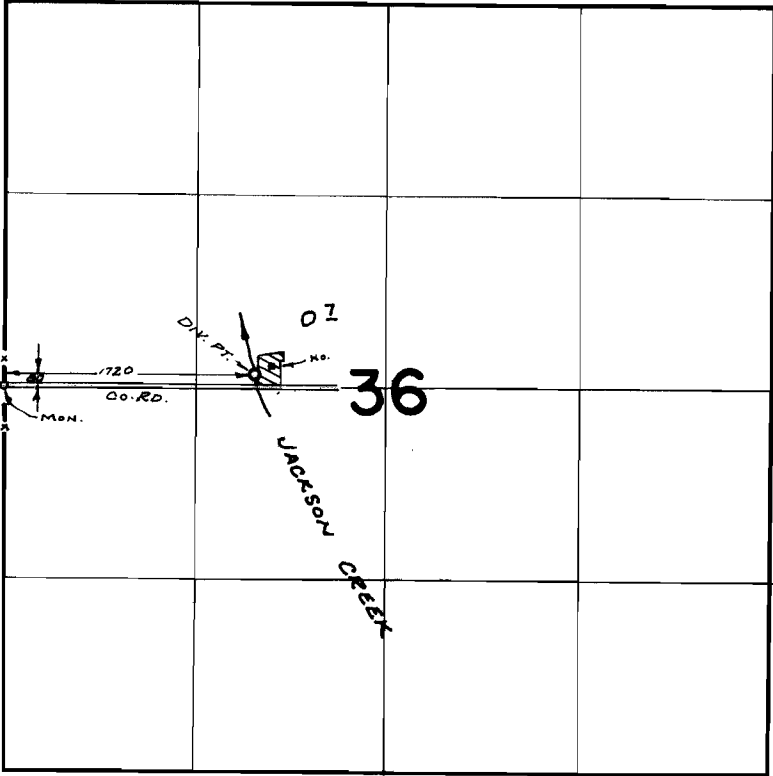

**FINAL PROOF SURVEY**  
UNDER

Application No. *39718*..... Permit No. *29548*.....  
IN NAME OF

**CHARLES W. & EMMA M. JEHN**

Surveyed *MAY 21*, 1971, by *R. MUCKEN*