


# T.3S.R.1W.W.M.

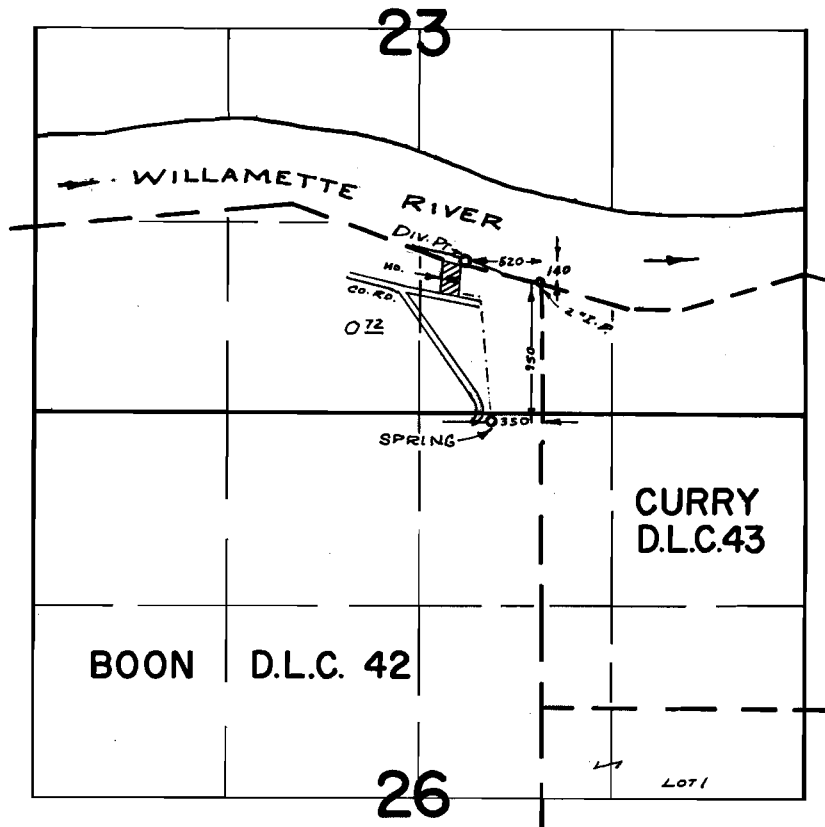

## FINAL PROOF SURVEY UNDER

Application No. 40732 Permit No. 30338  
IN NAME OF

FORREST G. & SHIRLEY E. MEGY

Surveyed MAY. 19. 1971, by R. MUCKEN