


# T. 4 S. R. 1 E. W. M.

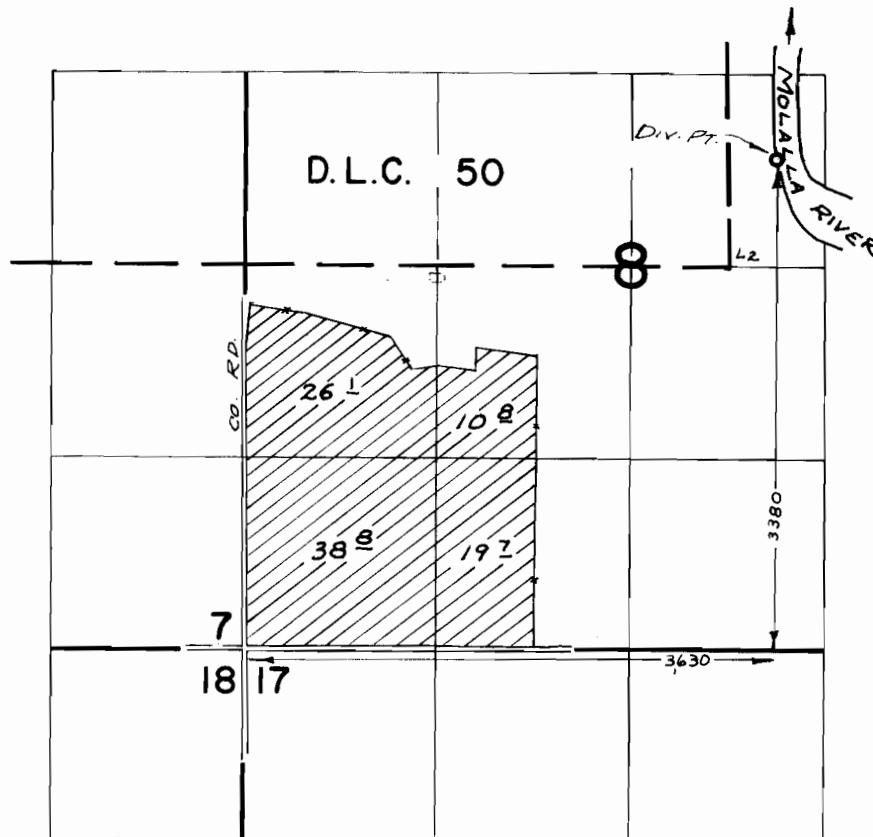

## FINAL PROOF SURVEY UNDER

Application No. 47002 Permit No. 35062  
IN NAME OF

ZIEGLER FARM c/o VIOLA HURST

Surveyed Aug. 18, 1971, by R. MUCKEN