


T. 7 N.R. 10 W. W.M.

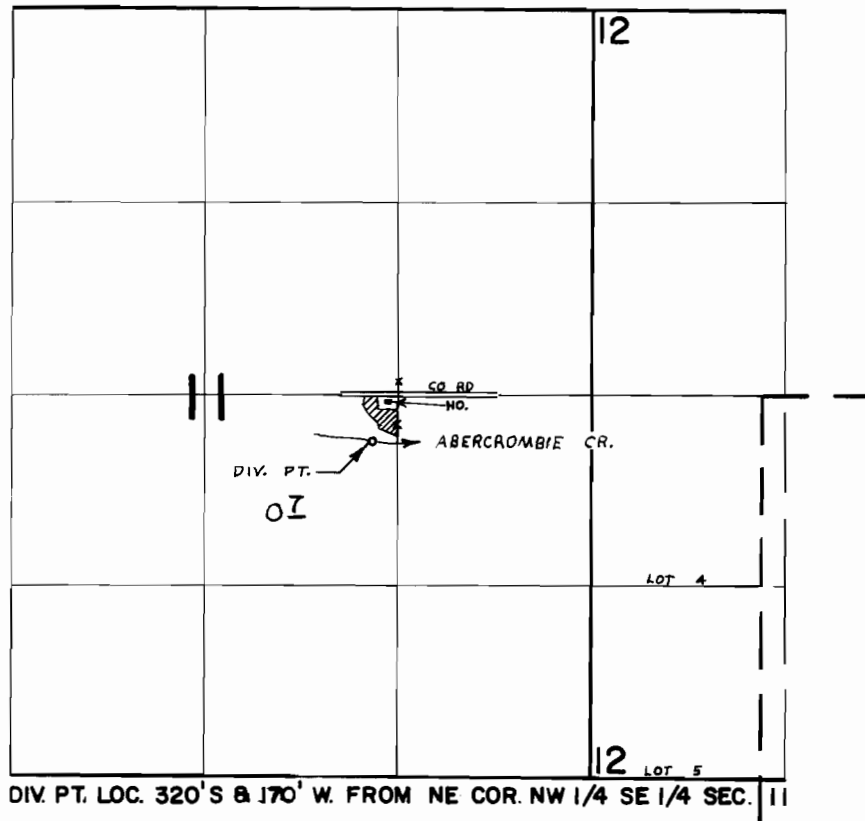

FINAL PROOF SURVEY
UNDER

Application No. 41735 Permit No. 31157
IN NAME OF

Augustus M. Fennerty

Surveyed JUNE 9, 1971, by R. MUCKEN