


T.4N.R.10W.W.M.

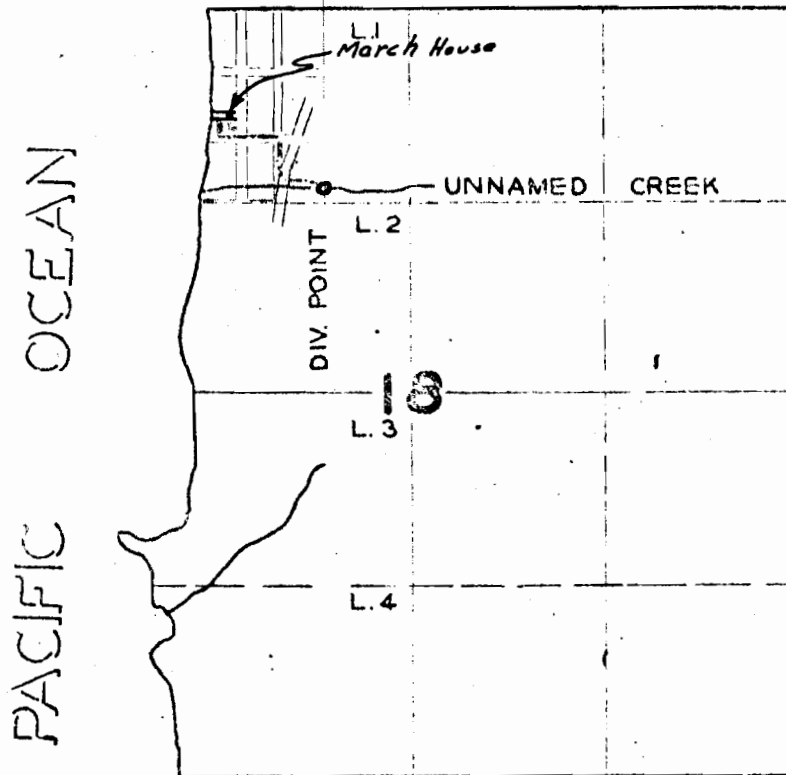

FINAL PROOF SURVEY
UNDER

Application No. 19259. Permit No. 14859.
IN NAME OF

.....CHAS. V. PHILLIPS.....

Surveyed JULY 20 1950, by H.L. COFFMAN

app. no. 43285
per. no. 32350