


T. 24 S. R. 3 W. W. M.

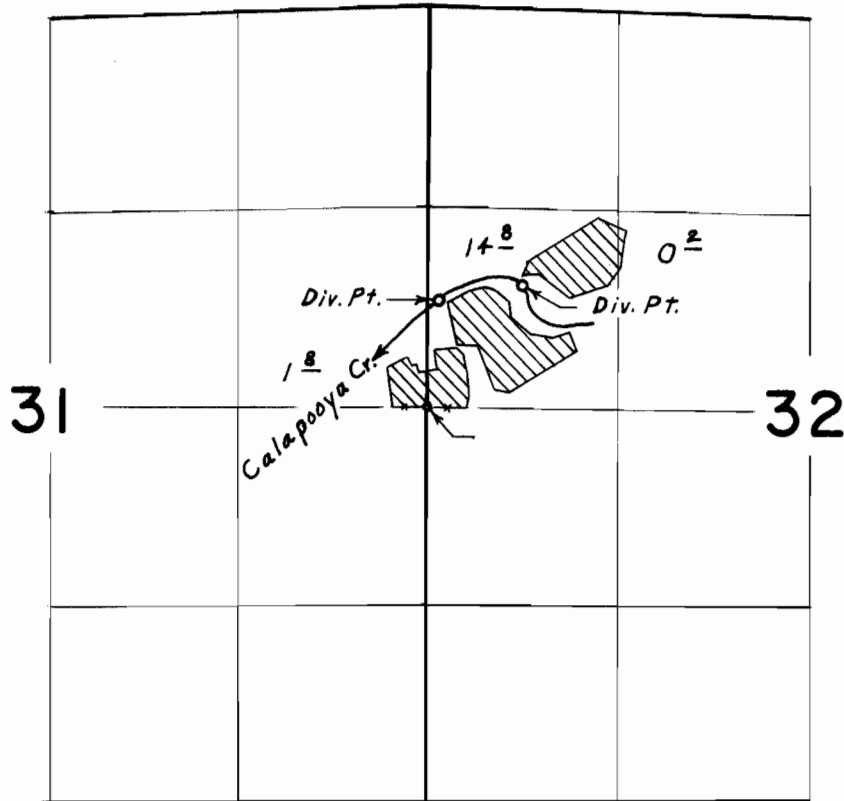

Div. Pts. located: 840' N. & 650' E.; 790' N. & 80' E.; from W. $\frac{1}{4}$ Cor. Sec. 32

FINAL PROOF SURVEY
UNDER

Application No. 38561.. Permit No. 28729..
IN NAME OF

GERALD A. NEWELL

Surveyed May 14, 1971., by L. E. Gould