


T. 20 & 2 | S. R | | W. W. M.

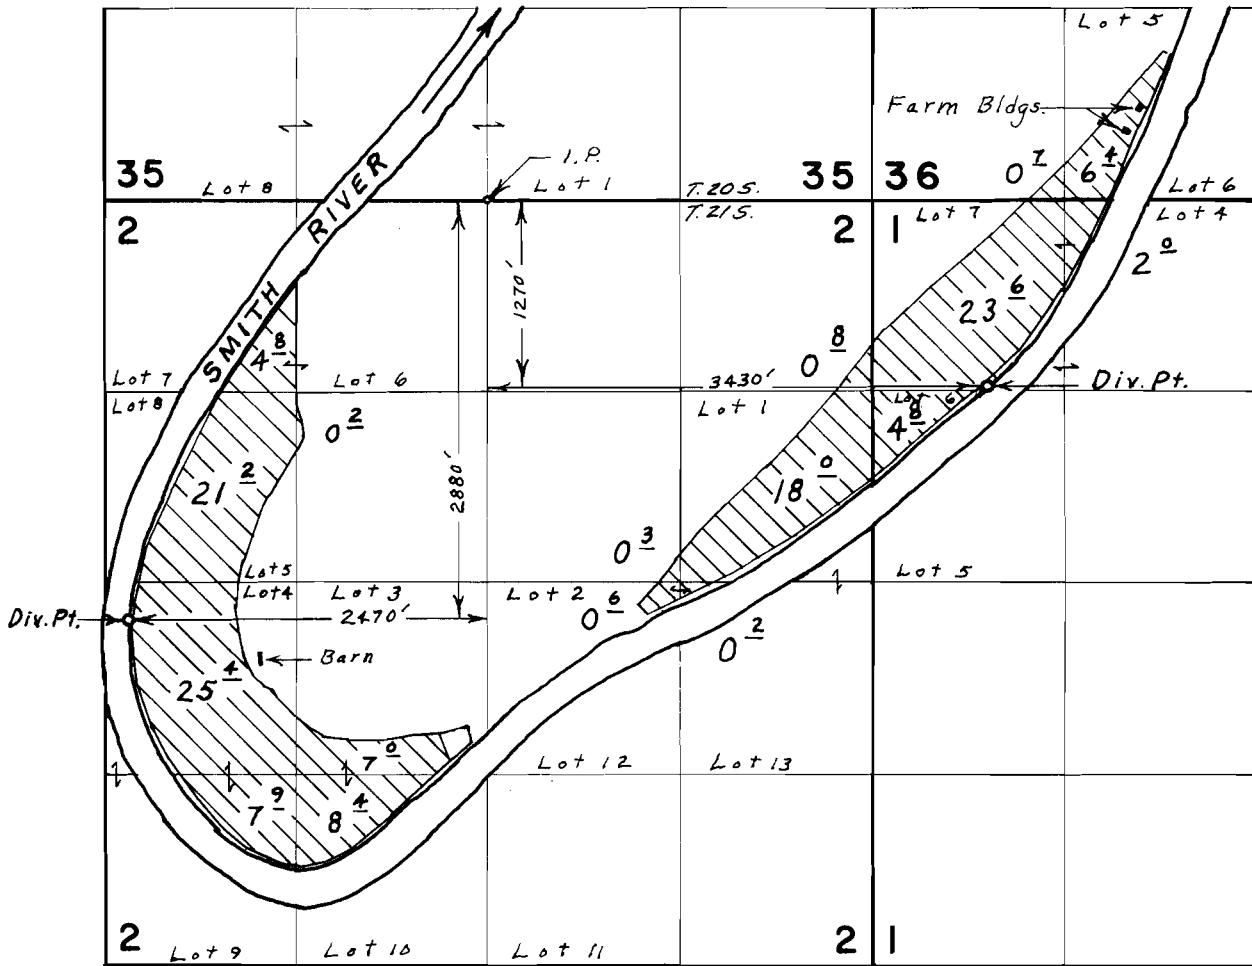

FINAL PROOF SURVEY UNDER

Application No. 44063. Permit No. 32926.
IN NAME OF

COOS HEAD TIMBER COMPANY

Surveyed Oct. 18, 1971, by L. E. Gould