


T 9 & 10 S. R. 26 E. W. M.

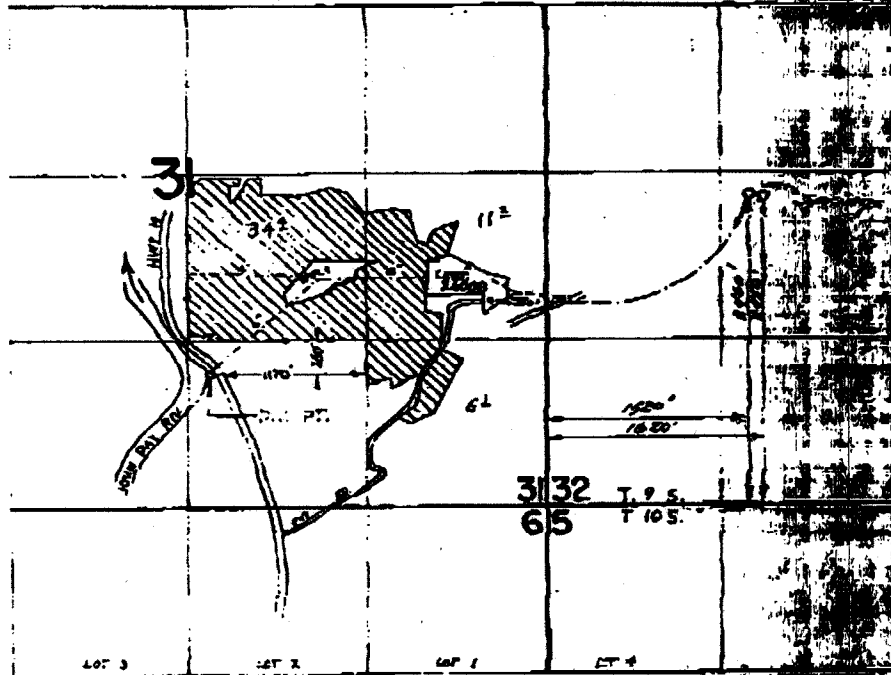

FINAL PROOF SURVEY UNDER

60983 45519
Application No. 43538 Permit No. 32568
IN NAME OF

EVERETT WHEELER

Surveyed JULY 20, 1971, by R. MUCKEN
OCT. 6, 1981, *Ala*

58741
38536