


33916
38537

T.9S.R.26E.W.M.

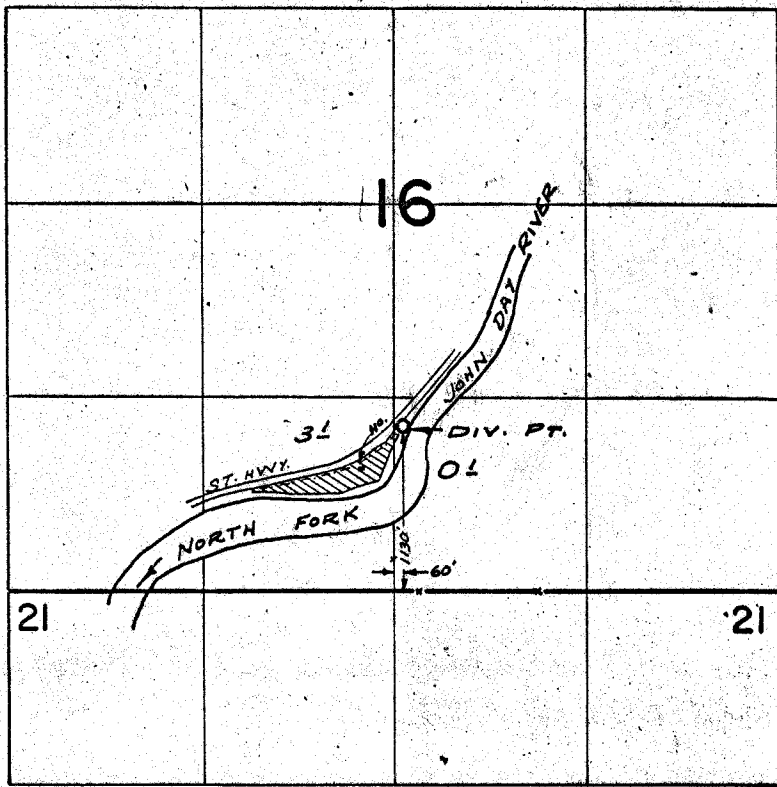

FINAL PROOF SURVEY UNDER

Application No. 45446 Permit No. 33916
IN NAME OF

GENE & DONNA CAMPBELL

Surveyed July 13, 1971, by R. MUCKEN