


T. 35 S. R. 4 W. W.M. .

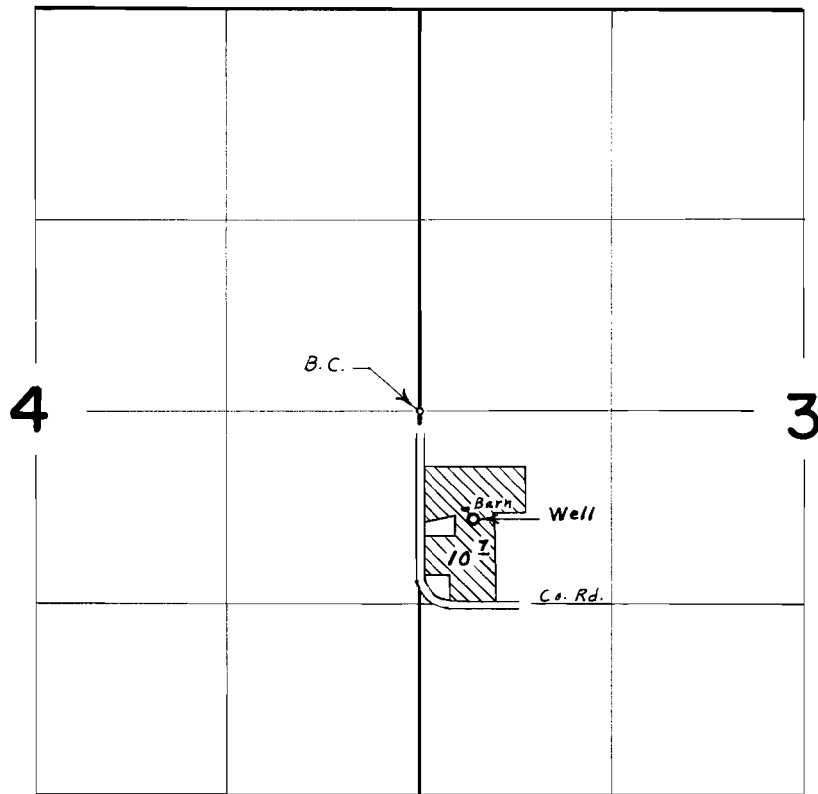

Well located 740' S. & 370' E. from W. $\frac{1}{4}$ Cor. Sec. 3

FINAL PROOF SURVEY
UNDER

Application No. G-3659 Permit No. G-3436
IN NAME OF

F. I. KELLEMS

Surveyed May 12, 1971, by L. E. Gould