


T. 3 4 S. R. 4 W. W. M.

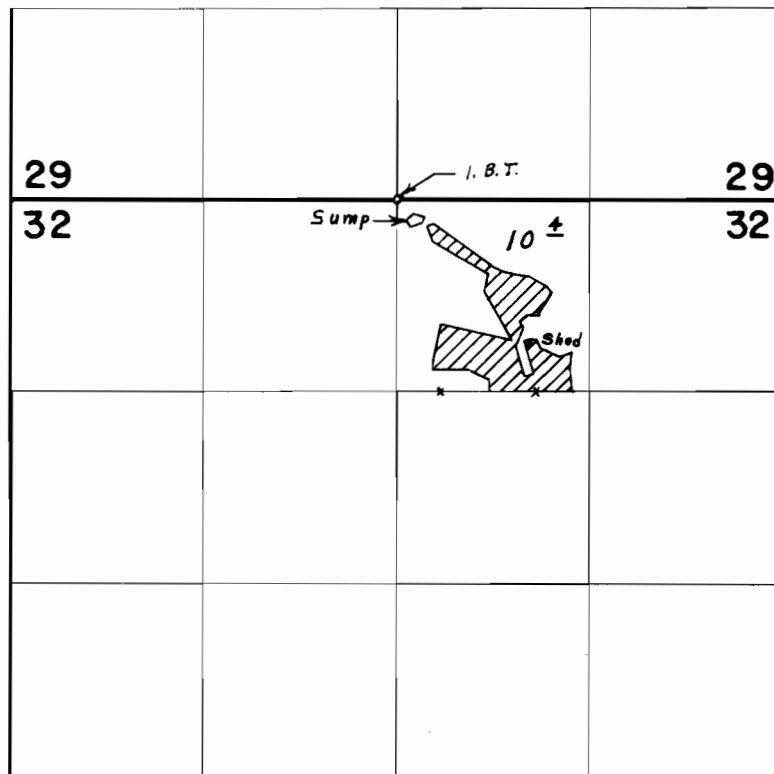

Sump located 140' S. & 130' E. from N. & Cor. Sec. 32

FINAL PROOF SURVEY UNDER

Application No. G-3710 Permit No. G-3509
IN NAME OF

IRVIN C. SHEPPERD

Surveyed May 13, 1971, by L. E. Gould