


T. 34 S. R. 4 W. W. M.

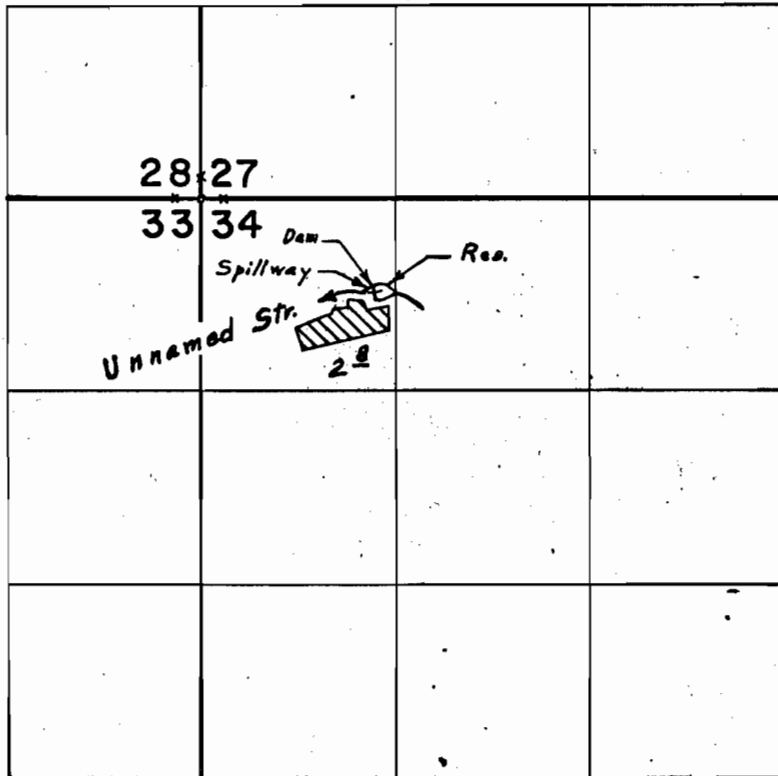

Div. Pt. located 640' S. & 1180' E. from N.W. Cor. Sec. 34

FINAL PROOF SURVEY
UNDER

R-42414 R-4800
Application No. 42415 Permit No. 31673
IN NAME OF

RAY ZWAN

Surveyed May 13, 1971, by L. E. Gould.