


T. 34 S. R. 4 W. W. M.

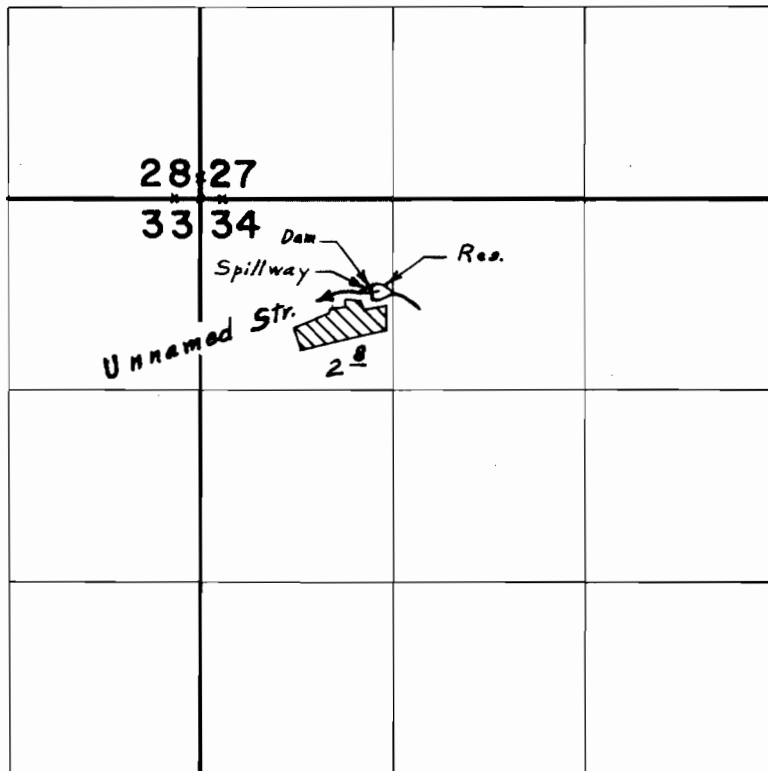

Div. Pt. located 640' S. & 1180' E. from N.W. Cor. Sec. 34

**FINAL PROOF SURVEY**  
UNDER

R-42414                      R-4800  
Application No. 42415      Permit No. 31673  
IN NAME OF

**RAY ZWAN**

Surveyed May 13, 1971, by L. E. Gould.