


T. 39 S. R. 2 W. W. M.

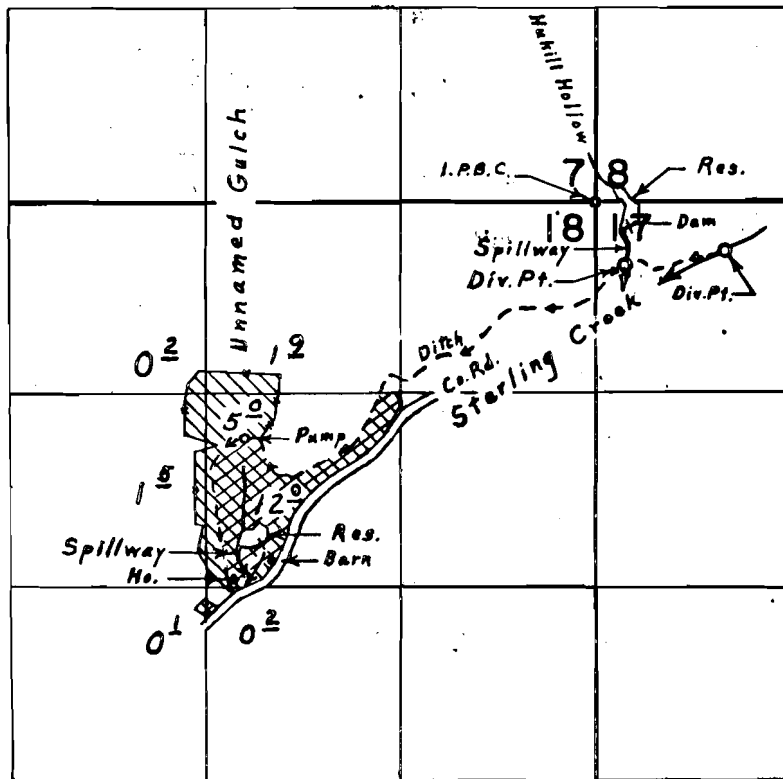

Div. Pts. located: Hukill Hollow, 430' S. & 190' E.; Sterling Cr., 380' S. & 870' E.; Brown Res., 2930' S. & 2260' W.; all from N. E. Cor. Sec. 18

FINAL PROOF SURVEY UNDER

R-45406 R-5365
 45407 33897
 Application No. 43689. Permit No. 32655. 

IN NAME OF

EARL M. & KAREEN H. BROWN

Surveyed Sept. 22, 1971, by L. E. Gould