


# T. 39 S. R. 2 W. W. M.

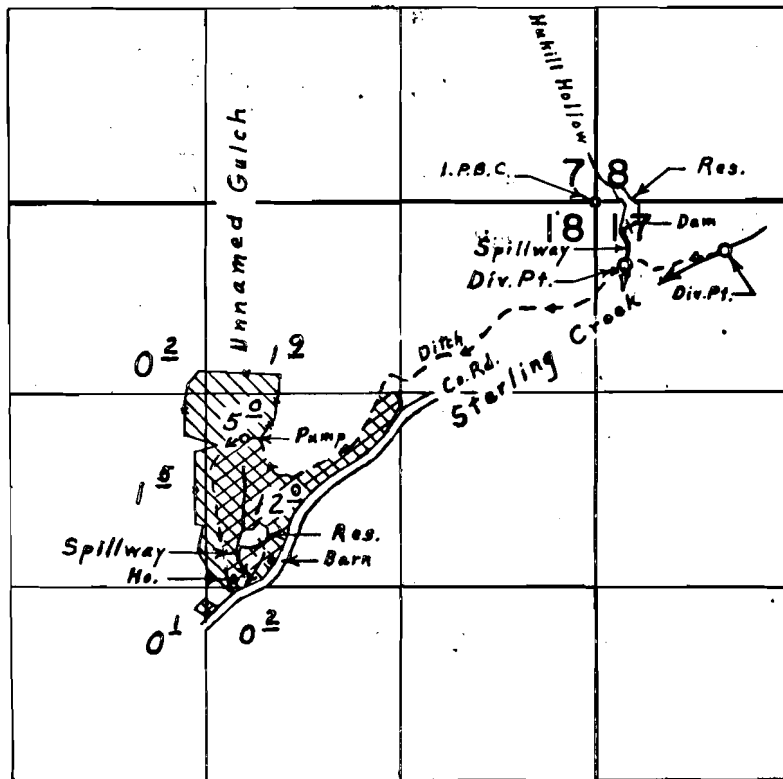

Div. Pts. located: Hukill Hollow, 430' S. & 190' E.; Sterling Cr., 388' S. & 870' E.; Brown Res., 2930' S. & 2260' W.; all from N. E. Cor. Sec. 18

## FINAL PROOF SURVEY UNDER

R-45406                      R-5365  
 45407                      33897  
 Application No. 43689. Permit No. 32655.   
 IN NAME OF

EARL M. & KAREEN H. BROWN

Surveyed Sept. 22, 1971, by L. E. Gould