



T. 39 S. R. 2 W. W. M.

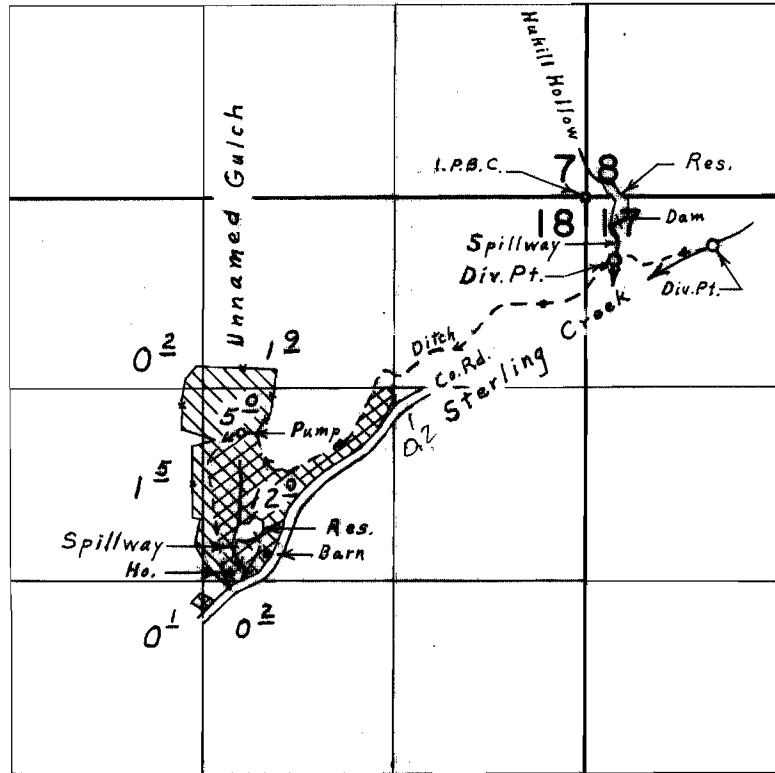

Div. Pts. located: Hukill Hollow, 430' S. & 190' E.; Sterling Cr., 380' S. & 870' E.; Brown Res., 2330' S. & 2260' W.; all from N. E. Cor. Sec. 18

FINAL PROOF SURVEY UNDER

R-45406 R - 5365
~~45406~~ ~~33897~~ 
 Application No. 43689 Permit No. 32655

IN NAME OF

EARL M. & KAREEN H. BROWN

Surveyed Sept. 22, 1971, by L. E. Gould