


T. 3 9 S. R. 3 W. W. M.

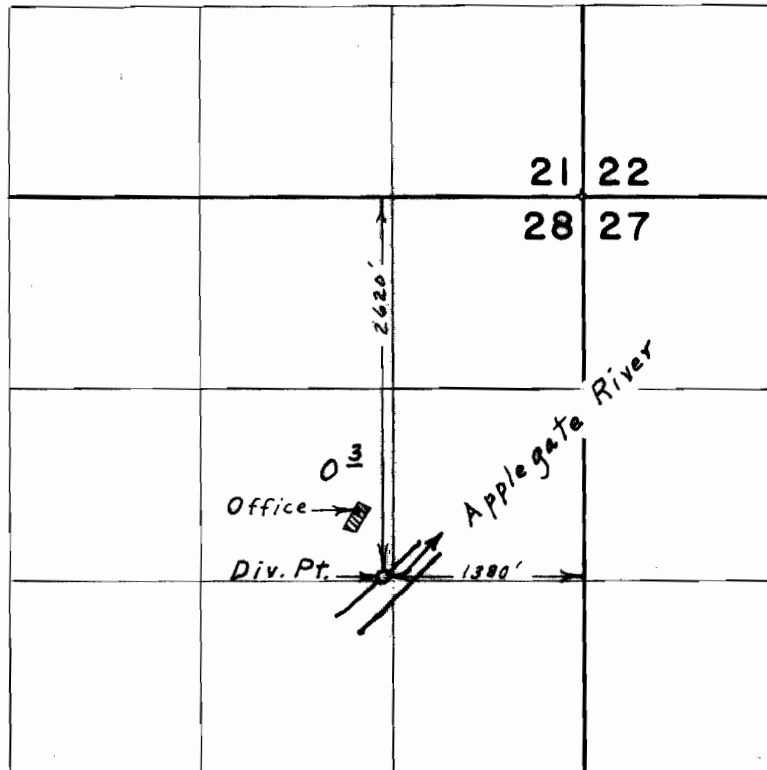

FINAL PROOF SURVEY
UNDER

Application No. 34485 Permit No. 27246
IN NAME OF

U. S. FOREST SERVICE

Surveyed Sept. 23, 1971, by L. E. Gould