


T. 34 S. R. 2 W. W. M.

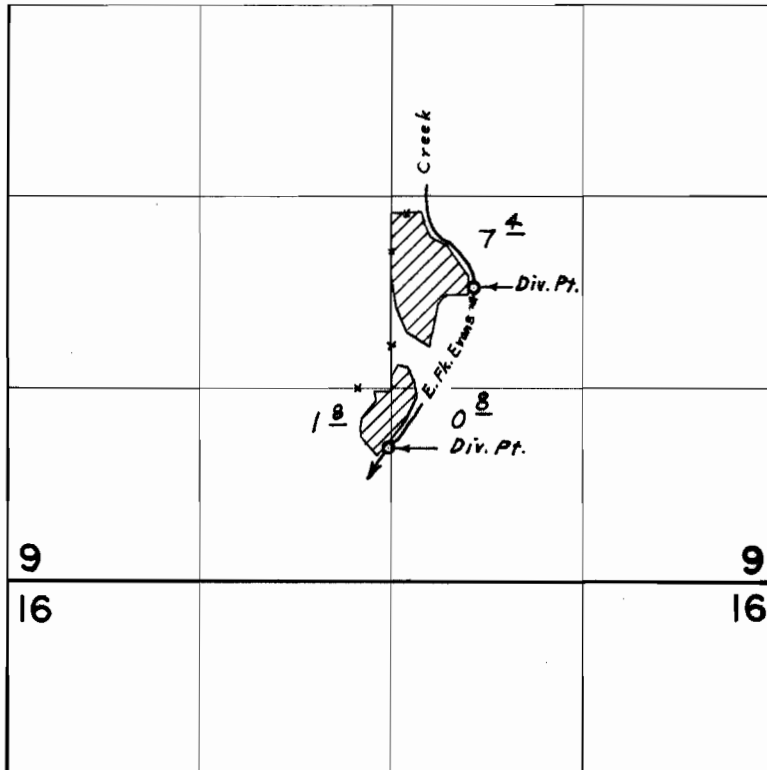

Div. Pts. located: 680' N. & 570' E.; 420' S. & 30' W.;
both from S.W. Cor. N.W. & S.E. & Sec. 9

FINAL PROOF SURVEY
UNDER

Application No. 39641 Permit No. 29454
IN NAME OF

CHARLES E. FRISK

Surveyed May 8, 1971, by L. E. Gould