


N.W. 1/4 OF S.W. 1/4 SEG. 4, T3 2
N.R. 9, E.W.M.

8

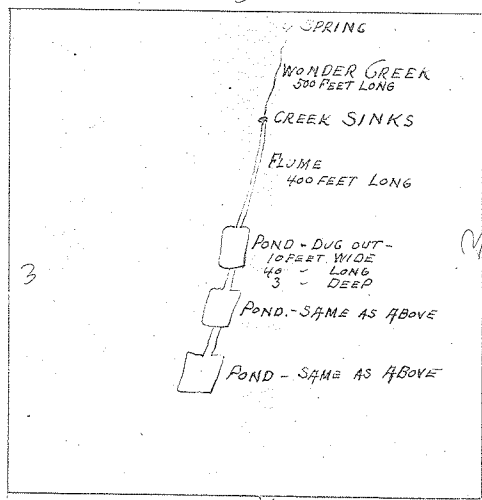

6

Application No. 6832
Permit No. 4280