


T. 35 S. R. 3 W. W. M.

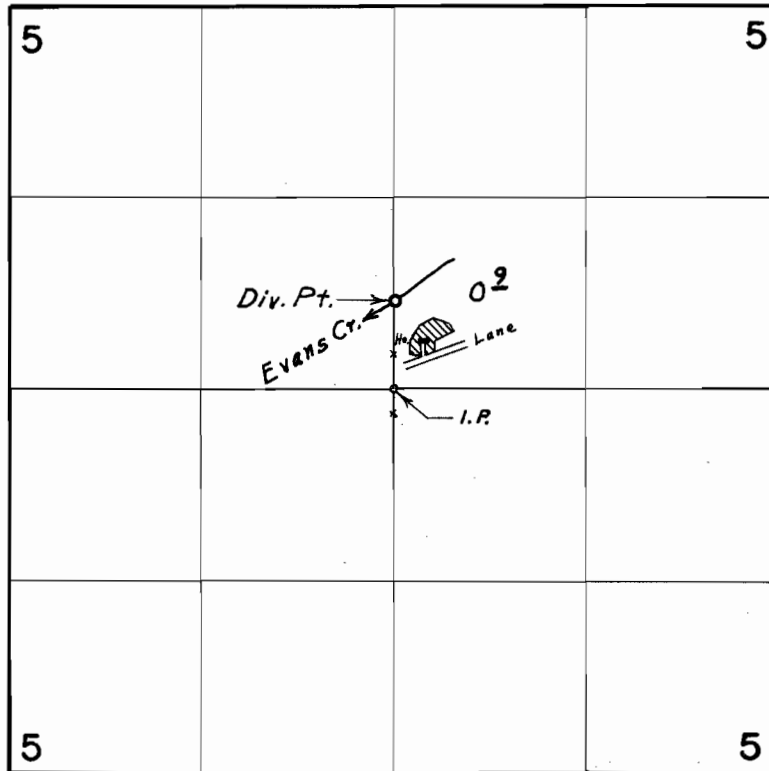

Div. Pt. located 610' N. & 10' E. from Center Section 5

FINAL PROOF SURVEY
UNDER

Application No. 41091 Permit No. 30610
IN NAME OF

HARLEY J. LUSE JR.

Surveyed May 10, 1971, by L. E. Gould