


T. 33 S. R. 2 E. W. M.

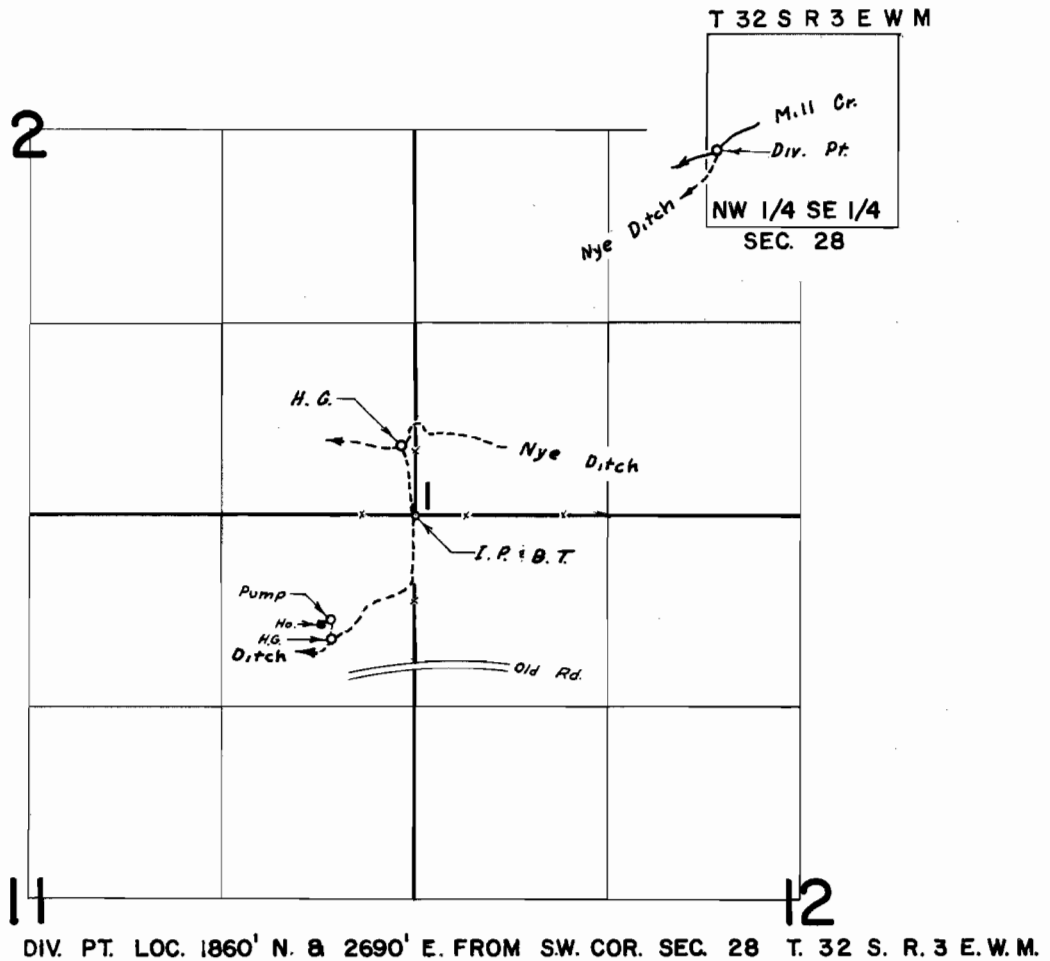

FINAL PROOF SURVEY UNDER

Application No. 41739..... Permit No. 31161.....
IN NAME OF

.....DORLAN F. WOODS.....

Surveyed SEP. 16., 1971., by L.E. Gould.....