


T. 33 S. R. 2 E. W. M

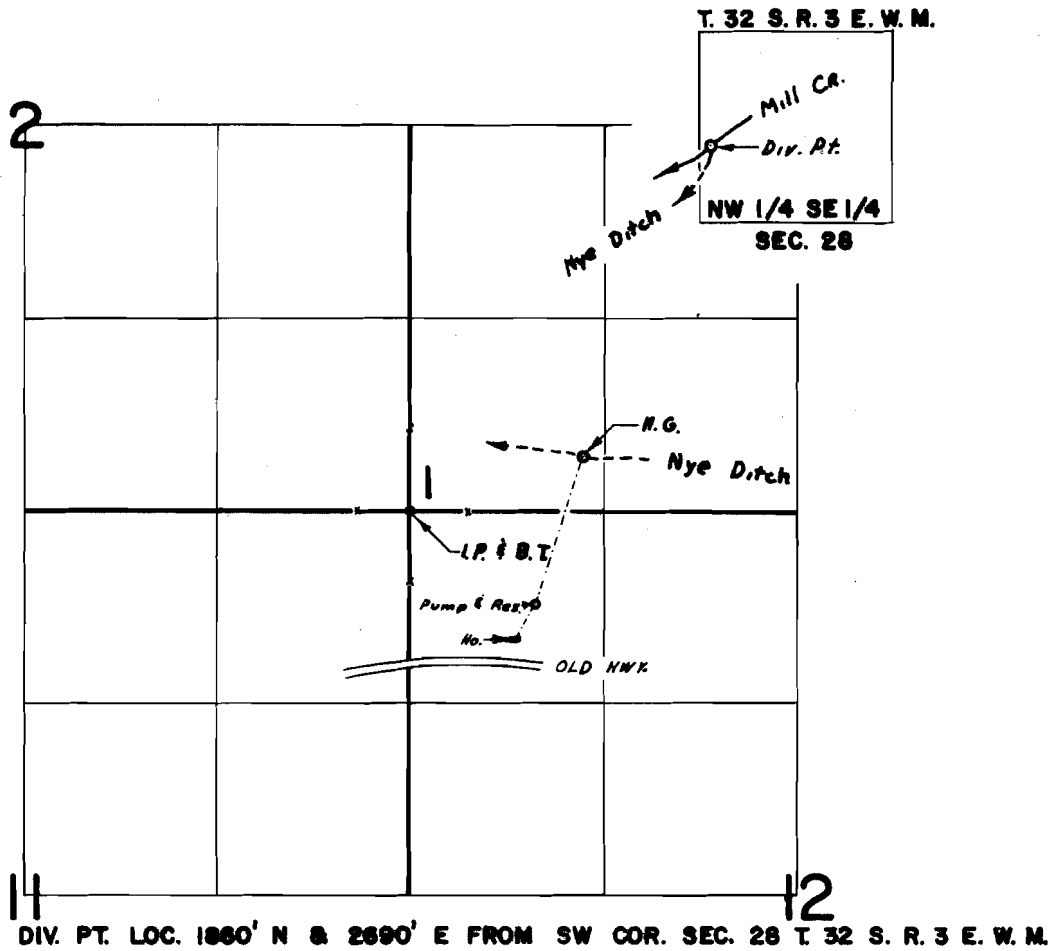

FINAL PROOF SURVEY
UNDER

Application No. 42175..... Permit No. 31561.....
IN NAME OF

ERNEST B. & HILDA R. KOLLMANN

Surveyed SEP. 15., 1971., by L. E. Gould.....