


T. 34 S. R. 1 W. W. M.

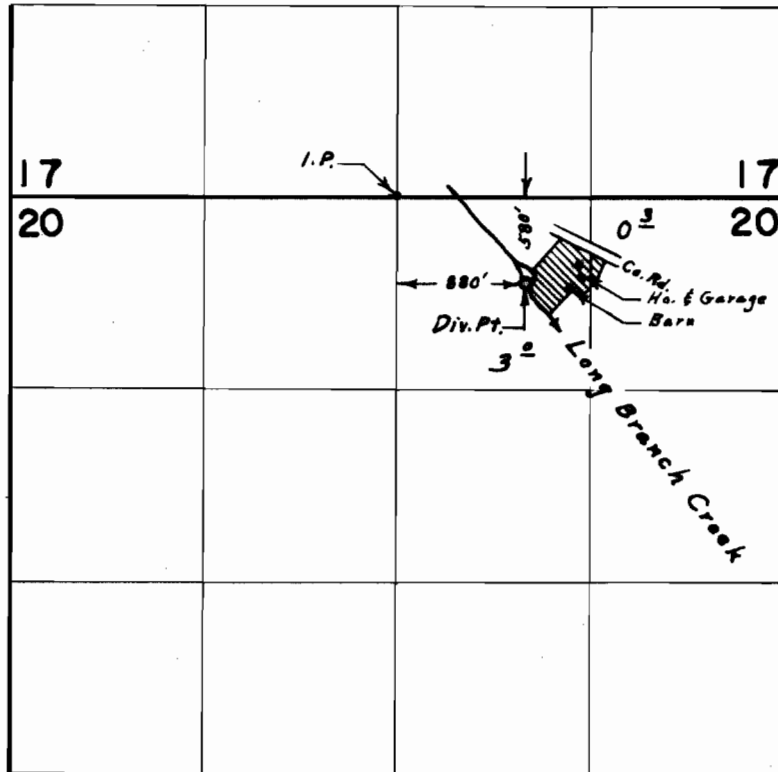

FINAL PROOF SURVEY
UNDER

Application No. 42799 Permit No. 31997
IN NAME OF

HAROLD L. & VELMA L. RICKS

Surveyed May 6, 1971, by L. E. Gould